


CERTIFIED RECORD OF LAND CORNER MONUMENTATION

**History of original corner establishment:**

This is the end of S. W. Nye Street for Sherwood Park Addition. The subsurface mark was set to replace surface mark during construction of the street.

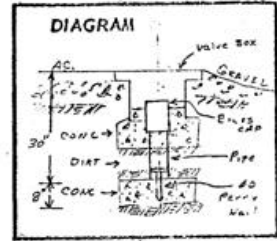


SW 1/4, NE 1/4, Sec. 16, T2N R32E

**Description of corner evidence found:**

Found 1" diameter bolt in concrete at surface and 26" below top of A C found 60 penny nail in concrete for subsurface mark.

**Description of monument and accessories established to perpetuate the original location of this corner**

Referenced 1" diameter bolt and removed it. Checked it with subsurface mark and found it in agreement. Reburied subsurface mark and set City of Pendleton brass cap in a valve box for the new surface monument. The cross at center of brass cap was set at true position from the reference marks.

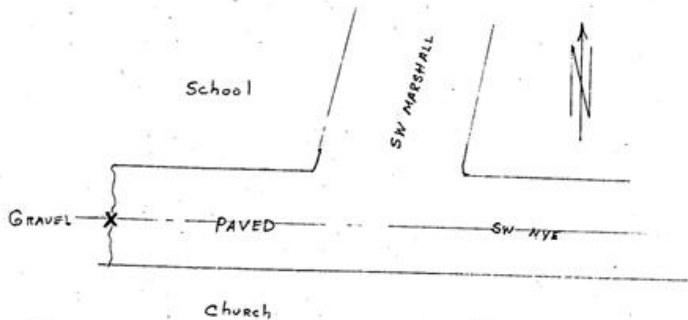

Submitted by City Engineering Dept.  
Pendleton, Oregon

*James L. Chaffee*  
City Engineer

Office of COUNTY SURVEYOR County of UMATILLA  
State of OREGON, I hereby certify that the within instrument was filed in this office  
for record on the 16 day of FEBRUARY, 1970, at 0 o'clock 00 m., (signed)  
*Ralph Thompson* by James L. Chaffee  
(COUNTY OFFICIAL) (DEPUTY)