

OREGON CORNER RESTORATION FORM

Section 4 Township 1N Range 32E
County Umatilla Date: August 5, 2009

Corner Designation: 1N32A13

Corner common to sections 33 and 34, T2N, R32E, and sections 3 and 4, T1N, R32E, W.M., Umatilla County, Oregon.


Condition Report Only
 Not found
 Remonumented
 Unrecorded
 Surveyed in
 Referenced out

Previous Renewals / Surveys, etc.

Corner originally set by David P. Thompson under contract No. 106 dated August 16, 1864. His record reads: Set post for corner to secs. 3, 4, 33 & 34 in mound of earth with charred stake, pits, trench, &c. as per instructions. Mr. Don Staebler, in survey I-41-B set a 3"x48" capped iron pipe. His record states: Dug and found Charcoal. Mr. Bill Wells, in survey 94-109-C set a brass cap. His record states: found 3" capped pipe.

Monument and Accessories found: (condition and source)
I found the brass cap by Mr. Wells in good condition.

DIAGRAM

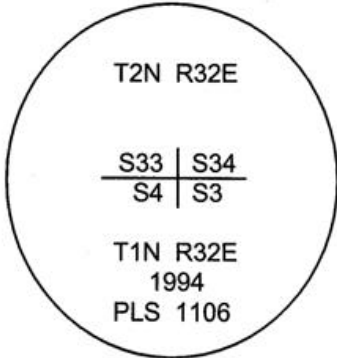

SKETCH

Monument and Accessories set:

None. This certificate is prepared to provide the state plane coordinates only.

The monument was tied using a Trimble R7/R8 RTK GPS System.

Location and comments
NAD 83/1991 State Plane Coordinates
Oregon North Zone.
N = 710,138.16 ift
E = 8,635,281.45 ift

Compass Declination
Firm / Agency
Witness Tree Surveying
Address
P.O. Box G
Pilot Rock, Or. 97868
Party Chief
Stephen K, Haddock

Surveyors Seal

RECEIVED BY:
Umatilla County Surveyor
Date: 6-10
Rec'd By: KK
No. 10-95-C

REGISTERED
PROFESSIONAL
LAND SURVEYOR

Stephen K. Haddock

OREGON
JULY 9, 2001
STEPHEN K. HADDOCK
56295LS

RENEWAL DATE 6-30-11