

PUBLIC LAND CORNER CONDITION REPORT

UMATILLA COUNTY, DATE: 01/25/02

CORNER DESIGNATION: 2N33A5, The Northeast corner of Section 6.

PREVIOUS RENEWALS/ SURVEYS, ETC..:

Most recent Umatilla County Surveyors recorded survey record: 86-109-B, which refers to a found 1917 GLO brass cap, we found a BLM brass cap at corner point but were unable to locate a remonumentation record.

MONUMENT AND ACCESSORIES FOUND:

Found a 3" brass cap on stainless steel pipe monument projecting 4" above ground level, marked as shown in monument marking detail. Found steel fence post 0.5 feet from corner.

MONUMENT MARKING DETAIL:

US DEPT OF INTERIOR
T3N R33E
S31
S6 | S5
T2N R33E
(Date unreadable)
BLM

LOCATION & COMMENTS:


Located at intersection of field lines South and East, North of NWB Truck Sales on Highway 11.

STATE PLANE COORDINATE, OREGON NORTH ZONE, NAD83/91, INT. FOOT:


N = 742233.52
E = 8655536.79

FIRM/AGENCY: William R. Wells
P.O. Box 1696
Pendleton, Oregon 97801

2N33A5

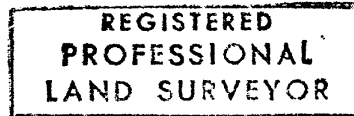

William R. Wells

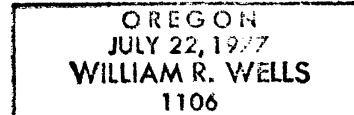

renews 6-30-02

RECEIVED BY

Umatilla County Surveyor

Date 2-02

Rec'd by KK

No. 02-43-9