

**PUBLIC LAND CORNER CONDITION REPORT**

**UMATILLA COUNTY, DATE:** 12/21/01

**CORNER DESIGNATION:** 2N33E11, The North Quarter Corner of Section 9.

**PREVIOUS RENEWALS/ SURVEYS, ETC.:**

Corner was remonumented by BLM Cadastral Surveyor Richard Johnson in recorded 1988-1989 BLM Survey.

**MONUMENT AND ACCESSORIES FOUND:**

Found 3" brass cap on 2 1/2" stainless steel pipe monument set flush with ground in small 1.5 foot diameter mound of stones, marked as shown in monument marking detail.

BLM bearing tree in Northwest quadrant is now 20" in diameter with blaze healed.

BLM bearing tree in Southwest quadrant is dead and down.

**MONUMENT MARKING DETAIL:**

T2N R33E

1/4 S4

S9

1988

BLM

**LOCATION & COMMENTS:**


**STATE PLANE COORDINATE, OREGON NORTH ZONE, NAD83/91, INT. FOOT:**

N = 737250.01


E = 8663640.37

**FIRM/AGENCY:** William R. Wells, PLS  
P.O. Box 1696  
Pendleton, Oregon 97801

2N33E11

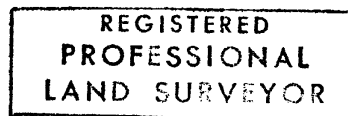

*William R. Wells*

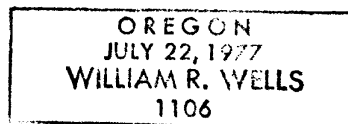

*renews 6-30-02*

RECEIVED BY

Umatilla County Surveyor

Date 2-02

Rec'd by KK

No. 02-43-9

*J*