

9-11

OREGON CORNER RESTORATION FORM

Section 9 Township 2N Range 33E

County Umatilla Date Jan. 1994

CORNER DESIGNATION

- Condition Report Only
- Not Found
- Renewed
- Unrecorded
- Surveyed In
- Referenced Out


9-11

Previous Renewals/Surveys, etc. _____


Monument(s) & Accessories Found: (Condition and Source)

Found $2\frac{1}{2}$ " Brass cap W. C. on 1" Pipe 30.00 ft. south of corner. Found 1" Pipe that had a brass cap 30.00 ft. North that is another W.C.

Monument Detail

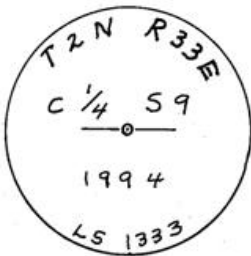

Sketch

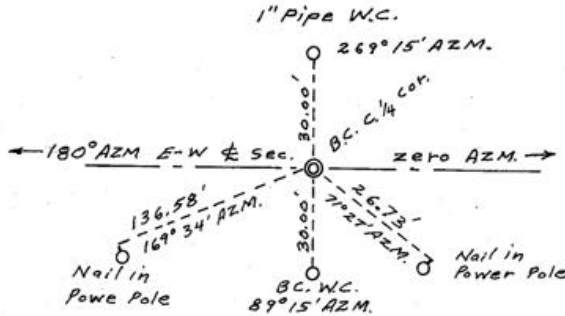

Monument Set (Procedures and Description)

Set $2\frac{1}{2}$ " brass cap on 1" x 30" G.I.P. 6" below surface of paving in a cast iron monument box with lid.

New Accessories

1. Set alum. nail in middle of a bearing object sign on E. face of Power Pole S. E. 26.73 ft. from the corner.
2. Set Alum. nail in middle of a bearing object sign on N. W. face of power pole S. W. 136.58 ft. from the corner.

Location & Comments

corner approximately 2 ft. S. of centerline of paving

Compass Declination _____

Firm/Agency Don Staebler

Engineer-Surveyor _____

Address 1532 S. W. 41

Pendleton, OR 97801

Party Chief Don Staebler

Notes _____

Witness _____

Surveyor's Seal



Donald L. Staebler



RECEIVED BY _____
 Umatilla County Surveyor
 Date 2-94
 Rec'd By SK
 No. 94-08-M