

**PUBLIC LAND CORNER CONDITION REPORT**

**UMATILLA COUNTY, DATE:** 10/02/01

**CORNER DESIGNATION:** 2N33G5, The East 1/4 Corner of Section 7.

**PREVIOUS RENEWALS/ SURVEYS, ETC..:**

Most recent Umatilla County Surveyors recorded survey record: 99-276-B.

**MONUMENT AND ACCESSORIES FOUND:**

Found a 3" brass cap flush with the ground in good condition, marked as shown in monument marking detail. Found a location tag on a railroad tie fence corner stamped: T2N R33E SEC 8, 1/4, CORNER IS 42.0 FT WEST, BY: RJ, DATE: 10/88.

The Southeast corner of a wood frame house, 40 x 25 ft., bears N 26°06' W, 106.5 lks. dist., long side of house bears North and South.

**MONUMENT MARKING DETAIL:**

BLM  
T2N R33E  
1/4  
S7|S8  
1988

**LOCATION & COMMENTS:**


West side of Theater Land in right-of-way, fence running south along road approximately 2 feet West of Pacific Northwest Bell phone box.

**STATE PLANE COORDINATE, OREGON NORTH ZONE, NAD83/91, INT. FOOT:**


N = 734547.44  
E = 8655683.26

**FIRM/AGENCY:** William R. Wells  
P.O. Box 1696  
Pendleton, Oregon 97801

2N33G5

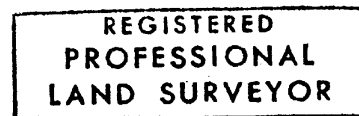

*William R. Wells*

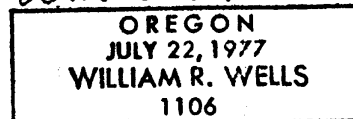

renews 6/30/02

RECEIVED BY

Umatilla County Surveyor

Date 5-02

Rec'd By KH

No. 02-110-9