

OREGON CORNER RESTORATION FORM

Section 9 Township 2N Range 33E

County UMATILLA Date MAY 1989

CORNER DESIGNATION

1/4 COR SEC 8/9, G-9

- Condition Report Only
- Not Found
- Renewed
- Unrecorded
- Surveyed In
- Referenced Out


Previous Renewals/Surveys, etc. _____

82-82-AX (WELLS, 1982)

Monument(s) & Accessories Found: (Condition and Source)

FOUND 1 1/2" YELLOW PLASTIC CAP MARKED "WALLULIS AND ASSOC."
0.3 FT BELOW GROUND

Monument Detail

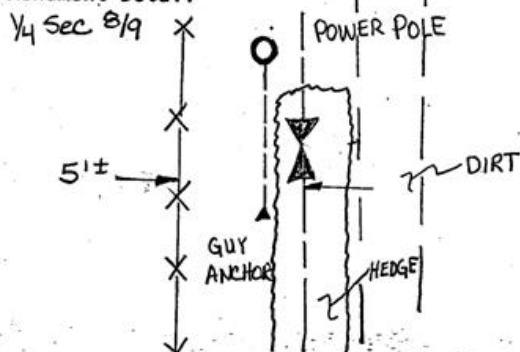

Sketch

Monument Set (Procedures and Description)

NONE

New Accessories

NONE

Location & Comments

NEW RECORD OF SURVEY Compass Declination _____

FOR UIR 8(1) Firm/Agency _____

MISSION HIGHWAY WHITE SHIELD, INC.

Address P.O. BOX 477

RECEIVED BY GRANDVIEW, WA 98930

Umatilla County Survey 701

Date 9-89

Record by MA

No. 89-92-B

Party Chief MICHAEL LEJEUNE

Notes _____

Witness THOMAS BAKER

Surveyor's Seal

REGISTERED
PROFESSIONAL
LAND SURVEYOR

R. David Schurian

OREGON
JUNE, 1976
R. DAVID SCHURIAN
1060