

PUBLIC LAND CORNER CONDITION REPORT

UMATILLA COUNTY, DATE: 02/11/02

CORNER DESIGNATION: 2N33J17, The Northeast Corner of Section 15.

PREVIOUS RENEWALS/ SURVEYS, ETC.:

Most recent Umatilla County Surveyors recorded corner record: 93-53-C.

MONUMENT AND ACCESSORIES FOUND:

Found a 2 1/2" brass cap buried 20" below ground, monument marked as shown in monument marking detail.

As per corner record accessories are as stated, although steel fence post with witness post sign is 3.0 feet North of corner monument.

MONUMENT MARKING DETAIL:

T2N R33E

S10 | S11

S15 | S14

1993

PLS 1106

LOCATION & COMMENTS:

Corner is located in farmed fields.


STATE PLANE COORDINATE, OREGON NORTH ZONE, NAD83/91, INT. FOOT:

N = 732165.43


E = 8671691.76

FIRM/AGENCY: William R. Wells
P.O. Box 1696
Pendleton, Oregon 97801

2N33J17

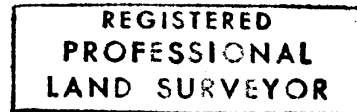

William R. Wells

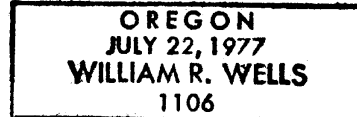

renews 6/30/02

RECEIVED BY

Umatilla County Surveyor:

Date 5-02

Rec'd By [Signature]

No. 02-112-9