

**PUBLIC LAND CORNER CONDITION REPORT**

**UMATILLA COUNTY, DATE:** 02/20/02

**CORNER DESIGNATION:** 2N33P9, The East 1/4 Corner of Section 20.

**PREVIOUS RENEWALS/ SURVEYS, ETC.:**

Most recent Umatilla County Surveyors recorded corner record: 97-222-C.

**MONUMENT AND ACCESSORIES FOUND:**

Found a 2 1/2" brass cap with top 6" below gravel road.  
Monument marked as shown in monument marking detail.  
As per corner record, accessories are intact.

**MONUMENT MARKING DETAIL:**

T2N R33E  
1/4  
S20|S21  
1997  
PLS 1106


**LOCATION & COMMENTS:** Corner is 5 feet West of East edge of County Road No. 1043.

**STATE PLANE COORDINATE, OREGON NORTH ZONE, NAD83/91, INT. FOOT:**


N = 723986.06  
E = 8661202.79

**FIRM/AGENCY:** William R. Wells  
P.O. Box 1696  
Pendleton, Oregon 97801

2N33P9

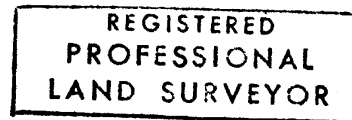

*William R. Wells*

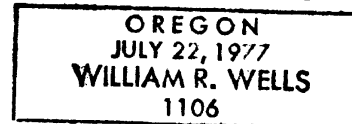

*renews 6/30/02*

**RECEIVED BY**

Umatilla County Surveyor  
Date 5-02  
Rec'd By KF  
No. 02-118-9