

**PUBLIC LAND CORNER CONDITION REPORT**

**UMATILLA COUNTY, DATE: 10/02/01**

**CORNER DESIGNATION: 2N33, R-7, The South 1/4 corner of Section 20.**

**PREVIOUS RENEWALS/ SURVEYS, ETC..:**

Most current is Umatilla County Surveyor's Corner Record No. 94-110-A.

**MONUMENT AND ACCESSORIES FOUND:**

Found a 2 1/2" brass cap monument, 6" below paved road in good condition, marked as shown in monument marking detail. Per recorded Corner Record, all accessories are intact. The corner has four accessories.

**MONUMENT MARKING DETAIL:**

T2N R33E

1/4 S20

S29

1994

RLS 1333

**LOCATION & COMMENTS:**

Corner located approximately 4 feet South of painted centerline of Tutuilla Church Road on South side of Road. Fences are located South and West. The corner is near the old Church building.


**STATE PLANE COORDINATE, OREGON NORTH ZONE, NAD83/91, INT. FOOT:**

N = 721261.41


E = 8658605.77

**FIRM/AGENCY:** William R. Wells, PLS  
P.O. Box 1696  
Pendleton, Oregon 97801

2N33R7

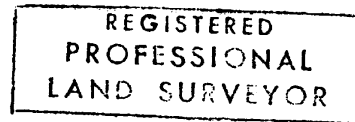

*Will. R. Wells*

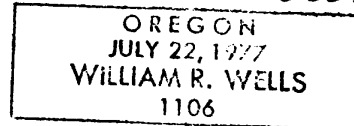

*renews 6-30-02*

RECEIVED BY  
Umatilla County Surveyor  
Date 12-01  
Rec'd By KK  
No. 01-211-9