

PUBLIC LAND CORNER CONDITION REPORT

UMATILLA COUNTY, DATE: 10/03/01

CORNER DESIGNATION: 2N33, V-5, The Southeast Corner of section 30.

PREVIOUS RENEWALS/ SURVEYS, ETC.:

Most current is Umatilla County Surveyor's Corner Record No. 88-1-A.

MONUMENT AND ACCESSORIES FOUND:

Found a 2 1/2" brass cap monument, 6" below ground gravel road in good condition, marked as shown in monument marking detail. Per recorded Corner record, all accessories are intact except the bearing object sign from accessory at S 73° 04' W is missing. This corner has two accessories.

MONUMENT MARKING DETAIL:

T2N R33E

S30 | S29

S31 | S32

1987

RLS 1333

LOCATION & COMMENTS:

Corner is located in the middle of County Raod.


STATE PLANE COORDINATE, OREGON NORTH ZONE, NAD83/91, INT. FOOT:

N = 715865.88


E = 8656092.26

FIRM/AGENCY: William R. Wells, PLS
P.O. Box 1696
Pendleton, Oregon 97801

√2N33V5

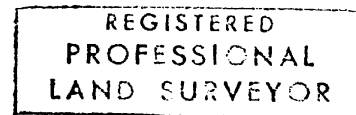

William R. Wells

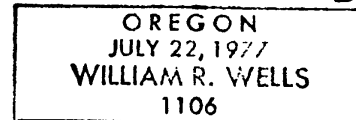

renews 6-30-02

RECEIVED BY
Umatilla County Surveyor
Date 12-01
Rec'd By KR
No. 01-211-9