

**PUBLIC LAND CORNER CONDITION REPORT**

**UMATILLA COUNTY, DATE:** 01/08/02

**CORNER DESIGNATION:** 2N33V7, The North Quarter Corner of Section 32.

**PREVIOUS RENEWALS/ SURVEYS, ETC..:**

Most recent Umatilla County Surveyors recorded corner record: 94-04-A.

**MONUMENT AND ACCESSORIES FOUND:**

Found a spike 10" below surface of Lloyd Road and another nail and "shiner" approximately 0.1 foot South. Tied the spike 10" below road surface per Survey 94-04-A. There is no corner certificate for this corner or corner accessories. Corner should be remonumented.

**MONUMENT MARKING DETAIL:**

**LOCATION & COMMENTS:**

Approximately 3 feet South of visual centerline of Lloyd Road (gravel) with field berm extending to the North.


**STATE PLANE COORDINATE, OREGON NORTH ZONE, NAD83/91, INT. FOOT:**

N = 715915.95


E = 8658741.03

**FIRM/AGENCY:** William R. Wells  
P.O. Box 1696  
Pendleton, Oregon 97801

2N33V7

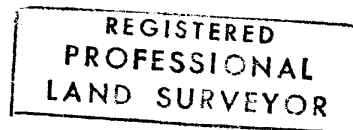

*William R. Wells*

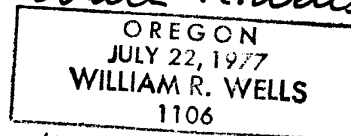

*renews 6-30-02*

RECEIVED BY

Umatilla County Surveyors

Date 2-02

Rec'd by KL

No. 02-43-9