


CERTIFIED RECORD OF LAND CORNER MONUMENTATION

**HISTORY OF ORIGINAL CORNER ESTABLISHMENT:**

Original GLO survey of the "Sub-subdivisions" of T2N, R33E, by Currin and Noland, 1887, states: "Deposited charred stake 12 inches in the ground for the 1/16 corner, dug pits 18x18x12 inches E. and W. of stake 5 1/2 ft. dist., raised mound of earth 1 1/2 ft. high 3 1/2 ft. base over it and in E pit drove stake 2 ft. long 2 ins. square 12 ins. in the ground marked 1/16S on N. face. (Survey by "3-mile rule")  
Refer also to C.E. Redfield, Indian Land Surveyor, Field Book 2, T2N, R33E, Pages 328-334, and Field Book 3, T2N, R33E, Page 25(121) for subdivisional ("3-mile rule") surveys of sections near and adjoining Section 34. We did not find Redfield field notes specifically for this C-W 1/16 corner of Section 34.

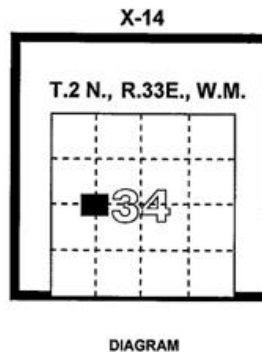

**DESCRIPTION OF CORNER EVIDENCE FOUND:**

Found a 2" diameter iron pipe, buried 1.2 feet in an open field and along an E-W farming line, bent to the SE, with 2 1/2" diameter brass cap marked as depicted below. This monument is of the identical size and description (except for specific corner markings) as the monument that currently exists at the Witness Corner for the South 1/16 corner between Section 27 and 28, T2N, R33E. The Redfield field books referred to above indicate the probable date of establishment of this monument as early 1918.

**DESCRIPTION OF MONUMENT AND ACCESSORIES ESTABLISHED TO PERPETUATE THE ORIGINAL LOCATION OF THIS CORNER:**

At the original position for the C-W 1/16 corner of section 34, T2N, R33E, determined by the position of the monument found and described above at a depth of 1.5 feet below ground surface, we set the following reference monuments:


A 5/8" X 30" iron rod (concrete reinforcing rod) with 1 1/2" diameter aluminum cap attached, marked: "APA OR 2849 WA 41295", set flush with ground bears S 88°35'14" W 179.51 ft.,

A 5/8" X 30" iron rod (concrete reinforcing rod) with 1 1/2" diameter aluminum cap attached, marked: "APA OR 2849 WA 41295", set flush with ground bears N 67°16'57" W 196.70 ft.

These two reference monuments are the Easterly corners of Parcel 2 of a Land Partition performed for the Confederated Tribes of the Umatilla Indian Reservation and recorded as Umatilla County Survey No. 08-149-B

I hereby certify that the above corner position was perpetuated as hereon described in October of 2008.

Witnesses: Michael B. Posada, PLS 2489, Gary Langlitz, PLS

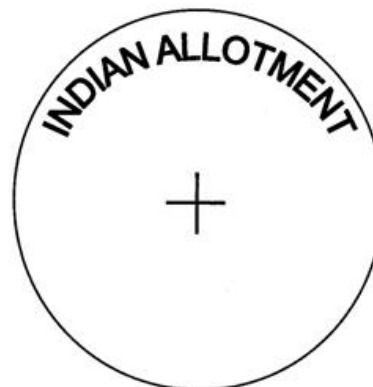

EXPIRES: 12-31-10

DATED: 01-15-09

RECEIVED BY  
Umatilla County Surveyor  
DATE 1-09  
FILED BY KK  
NO. 78.0