

PUBLIC LAND CORNER CONDITION REPORT

UMATILLA COUNTY, DATE: 12/31/01

CORNER DESIGNATION: 2N33, Z-7, the North 1/4 Corner of Section 5.

PREVIOUS RENEWALS/ SURVEYS, ETC..:

Corner was reestablished per Umatilla County Surveyor's Survey No. 82-71-AX.

MONUMENT AND ACCESSORIES FOUND:

Found 1 1/2" aluminum cap on 5/8" rebar. Cap is 1" below road surface and marked as shown in monument marking detail. The corner does not have a Corner Record.

MONUMENT MARKING DETAIL:

WALLULIS & ASSOC. INC.

T2N R33E

SEC 32

SEC 5

T1N R33E

LOCATION & COMMENTS:

Corner about 2' South of the centerline of Best Road. There is a fence extending North and a field line extending South from corner.


STATE PLANE COORDINATE, OREGON NORTH ZONE, NAD83/91, INT. FOOT:

N = 710581.56


E = 8658904.83

FIRM/AGENCY: William R. Wells, PLS
P.O. Box 1696
Pendleton, Oregon 97801

\2N33Z7

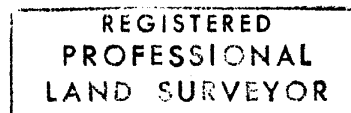

Will. R. Wells

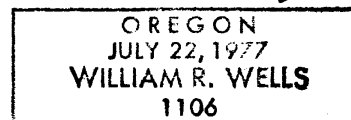

renews 6-30-02

RECEIVED BY

Umatilla County Surveyor

Date 2-02

Rec'd By KK

No. 02-47-g