

Index

File No. _____

CORNER RECORD (SEARCH)

(Ref. FSM 7151.4)

Tract or

Survey No. U.I.R.

Cor.

No. 37 1/2 M

T 2N R. 36E

R.D. WALLA WALLA


County UMATILLA

Merid. WILLAMETTE

N.F. UMATILLA

State OREGON

CORNER DIAGRAM

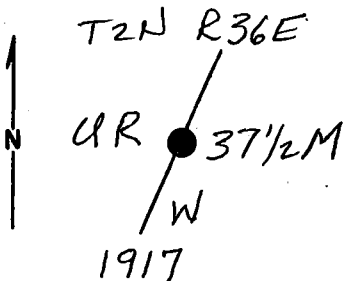

DESCRIBE CORNER MONUMENT FOUND

G.L.O. BRASS CAPPED IRON PIPE. CAP IS MARKED AS SHOWN IN THE CORNER DIAGRAM. PIPE IS LEANING SOUTH. STONES DOWN SLOPE - NONE WITH MARKS.

DESCRIBE BEARING TREES OR OTHER OFFICIAL ACCESSORIES FOUND

ORIG. 12" IS NOW A LIVE 18" PONDEROSA PINE WITH A SINGLE HEALED BLAZE. BEARS N 54° W, 72 LINKS.
 ORIG. 15" FIR (IDENTIFIED AS A 28" PINE IN 1917) IS NOW A 36" DOUGLAS FIR WITH FAINT HEALED SCAR, BARK IS BADLY BURNT. BEARS S 42° E, 35 LINKS. (LIVE)

PHOTO IDENTIFICATION DATA

Photo No. _____

Filed At. _____

Object Ident. _____

Ident. By _____

Signature

PLANE COORDINATE POSITION DATA

State _____ Zone _____

X _____

Y _____

Estab. By _____

Agency

Signature

Division

Headquarters

Date

FS-7100-52 (3/68)

Norris L. Daylong PLS 1636

S.O.

APRIL 12, 1991

CORNER RECORD (PERPETUATION)

MONUMENT: DESCRIBE NEW MONUMENT SET, OR WORK DONE TO PRESERVE EXISTING MONUMENT

ACCESSORIES : DESCRIBE NEW BT'S WITNESS OBJECTS ETC. ESTABLISHED, OR WORK DONE TO PRESERVE EXISTING EVIDENCE

Work Done By _____ Title _____ Date _____ State Registration No. _____
or Agency _____

Certified Cor. Record Prepared ? Yes No Filed At: _____ Date _____

REMARKS

Index File No. T. R. M. Tract or Surv. No. Cor.


USDA-FOREST SERVICE
Index U.I.R.-MOR-37½
File No.

CORNER RECORD (SEARCH)
(Ref. FSM 7151.4)

Tract or Survey No. UIR Cor. No. 37½

T 2N R. 36E R.D. _____ County _____
Merid. Williamette N.F. Umatilla State Oregon

CORNER DIAGRAM

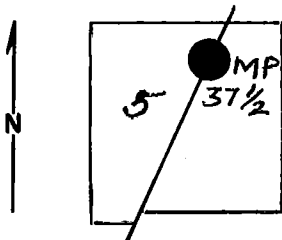

DESCRIBE CORNER MONUMENT FOUND

Brass Cap: 2" diameter wired in NE-SW fence



DESCRIBE BEARING TREES OR OTHER OFFICIAL ACCESSORIES FOUND

None.

PHOTO IDENTIFICATION DATA

Photo No. _____
Filed At. _____
Object Ident. _____
Ident. By _____

Signature

DESCRIBE CORNER LOCATION RELATIVE TO NEAR-BY FEATURES, ALSO HOW TO REACH CORNER

PLANE COORDINATE POSITION DATA

State _____ Zone _____
X _____
Y _____
Estab. By _____

Agency

Signature

B. Moore

Title

Division

Headquarters

Date
11/5/79

7100-52-(3/68)

5

CORNER RECORD (PERPETUATION)

MONUMENT: DESCRIBE NEW MONUMENT SET, OR WORK DONE TO PRESERVE EXISTING MONUMENT

ACCESSORIES : DESCRIBE NEW BT'S WITNESS OBJECTS ETC. ESTABLISHED, OR WORK DONE TO PRESERVE EXISTING EVIDENCE

Work Done By _____ Title _____ Date _____ State Registration No. _____
or Agency _____
Certified Cor. Record Prepared ? Yes No Filed At: _____ Date _____

REMARKS

Brass cap may or may not be in original location

Index File No. T. R. M. Tract or Surv. No. Cor. U.S. G.P.O. 1977-725-576/588