

USDA-FOREST SERVICE

Index File No. T-5

CORNER RECORD (SEARCH)

(Ref. FSM 7151.4)

Tract or Survey No. _____ Cor. No. T-5


T R 11 R. 36 E

R.D. Pond County _____

Merid. Williamette

N.F. Umatilla State Oregon

CORNER DIAGRAM

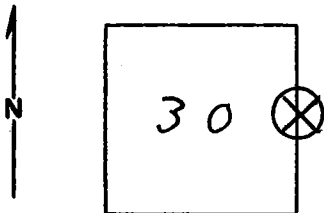

DESCRIBE CORNER MONUMENT FOUND

stone - call size
sets in stone mound on small bench.

DESCRIBE BEARING TREES OR OTHER OFFICIAL ACCESSORIES FOUND

32" P. Pine - N 45 E - approx. 100' dist,
closed block facus mound.

PHOTO IDENTIFICATION DATA

Photo No. _____
Filed At. _____
Object Ident. _____
Ident. By _____
Signature

DESCRIBE CORNER LOCATION RELATIVE TO NEAR-BY FEATURES, ALSO HOW TO REACH CORNER

mound is located on west facing slope
approx. 1100 ft. East of Rail Road. It is
SW. of end of Timber strip.

PLANE COORDINATE POSITION DATA

State _____ Zone _____
X _____
Y _____
Estab. By _____
Agency

Signature

Moore

Title

Eng. Tech.

Division

Headquarters

Date

3/19/79

7100-52-(3/68)

CORNER RECORD (PERPETUATION)

MONUMENT: DESCRIBE NEW MONUMENT SET, OR WORK DONE TO PRESERVE EXISTING MONUMENT

I placed a bluish bearing iron tag and an attention post on the assumed B.T.

ACCESSORIES : DESCRIBE NEW BT'S WITNESS OBJECTS ETC. ESTABLISHED, OR WORK DONE TO PRESERVE EXISTING EVIDENCE

9

10

Work Done By _____ Title _____ Date _____ State Registration No. or Agency _____

Certified Cor. Record Prepared ? Yes No Filed At: _____ Date _____

11

REMARKS

12

Index File No. T. R. M. Tract or Surv. No. Cor.

T-5