


Index File No. V-5
 T 2N R. 36E
 Merid. WILLAMETTE N.F. UMATILLA State OREGON

CORNER RECORD (SEARCH)

(Ref. FSM 7151.4)

Tract or Survey No. _____
 Cor. No. _____

CORNER DIAGRAM

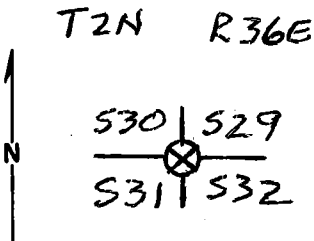

DESCRIBE CORNER MONUMENT FOUND

POST & STONE MOUND GONE - CORNER IS ABOUT 30' SOUTH OF A SMALL DRAINAGE ON A VERY STEEP WEST SLOPE.

DESCRIBE BEARING TREES OR OTHER OFFICIAL ACCESSORIES FOUND

ORIG. 12" PINE IS A 20" PONDEROSA PINE WITH A LARGE HEALED BLAZE, BEARS S 30°W, 134 FT.
 ORIG. 10" PINE IS A 18" PONDEROSA PINE WITH A HEALED BLAZE, BEARS N 60°W, 145 FT.
 I PUT BT & LSM SIGNS ON BOTH TREES.

DESCRIBE CORNER LOCATION RELATIVE TO NEAR-BY FEATURES, ALSO HOW TO REACH CORNER

BOTH TREES ARE HEALTHY. I PUT A LOCATION POSTER ON UTILITY POLE ON WEST EDGE OF ACCESS ROAD ABOUT 800 OR 900 FEET WEST OF CORNER. MICROICHE DOES NOT HAVE DESCRIPTION OF THIS CORNER.

PHOTO IDENTIFICATION DATA

Photo No. _____
 Filed At. _____
 Object Ident. _____
 Ident. By _____
Signature

PLANE COORDINATE POSITION DATA

State _____ Zone _____
 X _____
 Y _____
 Estab. By _____
Agency

Signature _____ Title _____ Division _____ Headquarters _____ Date _____ FS-7100-52 (3/68)

U. Dennis L. Hayward PLS 1634 S.D. NOV. 22, 1996

CORNER RECORD (PERPETUATION)

MONUMENT : DESCRIBE NEW MONUMENT SET, OR WORK DONE TO PRESERVE EXISTING MONUMENT

9

ACCESSORIES : DESCRIBE NEW BT'S WITNESS OBJECTS ETC. ESTABLISHED, OR WORK DONE TO PRESERVE EXISTING EVIDENCE

9

10

Work Done By _____ Title _____ Date _____ State Registration No. or Agency _____

Certified Cor. Record Prepared ? Yes No Filed At: _____ Date _____

11

REMARKS

12

Index File No. T. R. M. Tract or Surv. No. Cor. 13