

USDA-FOREST SERVICE

Index

File No. X-21

T 2N R. 36E

Merid. Willamette

CORNER RECORD (SEARCH)

(Ref. FSM 7151.4)

R.D. Walla Walla

N.F. Umatilla


County Umatilla

State Oregon

Tract or
Survey No. _____

Cor.
No. _____

CORNER DIAGRAM Sec.36

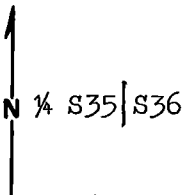

DESCRIBE CORNER MONUMENT FOUND

Stone 12x9x6 firmly set 6" in ground in a mound of small stones.
Definite chisle marks on West face but nearly unreadable.
Corner is on top of ridge.

DESCRIBE BEARING TREES OR OTHER OFFICIAL ACCESSORIES FOUND

Orig. 24" now 38" D-Fir N70W-81.4 ft. scribing visible on pre-viously opened blaze. (Record N70W-124 lks.).

PHOTO IDENTIFICATION DATA

Photo No. 1280-49

Filed At Umatilla N.F.

Object Ident. two I.P.'s

Ident. By L. [Signature]
Signature

PLANE COORDINATE POSITION DATA

State _____ Zone _____

X _____

Y _____

Estab. By _____
Agency

DESCRIBE CORNER LOCATION RELATIVE TO NEAR-BY FEATURES, ALSO HOW TO REACH CORNER

From the cabin near the SW 1/16 of Section 36-80 feet West of Rd.#3128 go West and Northwest along ridge top to corner 30 ft. West of Jeep trail.

Signature
Larry D. [Signature]
Title
Land Surveyor

Division _____

Headquarters _____

Date 6/83 7100-52-(3/68)

CORNER RECORD (PERPETUATION)

MONUMENT DESCRIBE NEW MONUMENT SET, OR WORK DONE TO PRESERVE EXISTING MONUMENT

Set 2½" x 30" Aluminum pipe with a 2½" Aluminum cap 8" in ground - built bound of stone 4 ft. base 20" high.

ACCESSORIES DESCRIBE NEW BT'S WITNESS OBJECTS ETC. ESTABLISHED, OR WORK DONE TO PRESERVE EXISTING EVIDENCE

7" P.Pine N16-3/4E-202.2 ft. scribed ¼S36BT and with a 1" Brass disk stamped PLS 896.

Work Done By Larry D. Bishop Title Surveyor Date 6/83 State Registration No. 896
or Agency

Certified Cor. Record Prepared ? Yes No Filed At: _____ Date _____

REMARKS

Set guard post North with signs 54-2 and 54-4.
Nailed 54-4 and BT signs to BT's as needed and painted band and blazes red.


Index
File No. X-21
T 2N R. 36E
Merid. Will

CORNER RECORD (SEARCH)
(Ref. FSM 7151.4)

Tract or
Survey No. _____
Cor.
No. _____

R.D. WALLA WALLA County UMATILLA
N.F. UMATILLA State OREGON

CORNER DIAGRAM

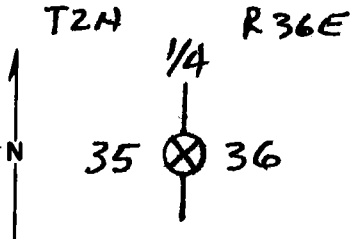

DESCRIBE CORNER MONUMENT FOUND

CORNER STONE IS SOLIDLY SET IN A MOUND OF SMALL STONES. SOME MARKS ARE VISIBLE ON WEST FACE. STONE IS SMALLER THAN RECORD, BUT ONLY ONE IN VICINITY.

DESCRIBE BEARING TREES OR OTHER OFFICIAL ACCESSORIES FOUND

A 30" FIR W/ "1/4S" VISIBLE ON PREVIOUSLY OPENED BLAZE BEARS N70°W ABOUT 70 FT. FROM STONE. (RECORD DIST. IS 813 FT)

PHOTO IDENTIFICATION DATA

Photo No. _____
Filed At. _____
Object Ident. _____
Ident. By _____
Signature

PLANE COORDINATE POSITION DATA

State _____ Zone _____
X _____
Y _____
Estab. By _____
Agency

DESCRIBE CORNER LOCATION RELATIVE TO NEAR-BY FEATURES, ALSO HOW TO REACH CORNER

CORNER IS JUST WEST OF JEEP RD. BT IS IN A SMALL GROUP OF TREES IN A LARGE GLADE.

Signature Dennis S. Gaylord *Title* _____ *Division* PLS 1636 *Headquarters* _____ *Date* 7-2-82 7100-52 (3. 68)

CORNER RECORD (PERPETUATION)

MONUMENT: DESCRIBE NEW MONUMENT SET, OR WORK DONE TO PRESERVE EXISTING MONUMENT

ACCESSORIES : DESCRIBE NEW BT'S WITNESS OBJECTS ETC. ESTABLISHED, OR WORK DONE TO PRESERVE EXISTING EVIDENCE

Work Done By _____ Title _____ Date _____ State Registration No. _____
or Agency _____

Certified Cor. Record Prepared ? Yes No Filed At: _____ Date _____

REMARKS

Index File No. T. R. M. Tract or Surv. No. Cor.