

Index

File No. X-25

CORNER RECORD (SEARCH)

(Ref. FSM 7151.4)

Tract or Survey No. \_\_\_\_\_

Cor. No. \_\_\_\_\_

T 2N R. 36E

R.D. Walla Walla

County Umatilla

Merid. Willamette


N.F. Umatilla

State Oregon

CORNER DIAGRAM Sec.36

DESCRIBE CORNER MONUMENT FOUND

Corner post gone.

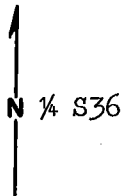

DESCRIBE BEARING TREES OR OTHER OFFICIAL ACCESSORIES FOUND

Orig. 18" Fir now a 30" Wh.Fir snag 30 ft. tall-N40W-20.5 ft. obvious double blaze.

Orig. 16" Fir now a shattered Wh.Fir snag 20 ft. tall-N85E-29.7 ft scribing visible on exposed upper blaze.

PHOTO IDENTIFICATION DATA

Photo No. 1280-50

Filed At. Umatilla N.F.

Object Ident. two I.P.'s

Ident. By *L. Williams*  
Signature

DESCRIBE CORNER LOCATION RELATIVE TO NEAR-BY FEATURES, ALSO HOW TO REACH CORNER

Corner is located 250 ft. North of Rd.#3128-070 where it crosses the East line Section 36.

PLANE COORDINATE POSITION DATA

State \_\_\_\_\_ Zone \_\_\_\_\_

X \_\_\_\_\_

Y \_\_\_\_\_

Estob. By \_\_\_\_\_  
Agency

Signature  
*Larry D. Williams*

Title  
Land Surveyor

Division \_\_\_\_\_

Headquarters \_\_\_\_\_

Date 6/83 7100-52-(3,68)

**CORNER RECORD (PERPETUATION)**

**MONUMENT: DESCRIBE NEW MONUMENT SET, OR WORK DONE TO PRESERVE EXISTING MONUMENT**

Set 2½" x 30" Aluminum pipe with a 2½" Aluminum cap 27" in ground.

**ACCESSORIES: DESCRIBE NEW BT'S WITNESS OBJECTS ETC. ESTABLISHED, OR WORK DONE TO PRESERVE EXISTING EVIDENCE**

11" Spruce N18W-18.4 ft. scribed XBT and with a 1" Brass disk stamped PLS 896.

9" Spruce S77½W-41.6 ft. scribed ¼S36BT and with a 1" Brass disk stamped PLS 896.

Work Done By Larry D. Bishop Title Surveyor Date 6/83 State Registration No. 896  
or Agency

Certified Cor. Record Prepared? Yes No  Filed At: \_\_\_\_\_ Date \_\_\_\_\_

**REMARKS**

Set guard posts North with signs 54-2 and 54-4.  
Nailed 54-4 and BT signs to BT's and painted band and blazes red.

Index File No. X-25

CORNER RECORD (SEARCH)  
(Ref. FSM 7151.4)

Tract or Survey No. \_\_\_\_\_  
Cor. No. \_\_\_\_\_


T 2N R. 36E

R.D. WALLA WALLA County UMATILLA

Merid. Will

N.F. UMATILLA State OREGON

CORNER DIAGRAM

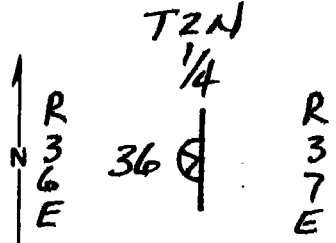

DESCRIBE CORNER MONUMENT FOUND

NONE - ORIGINAL POST IS GONE

DESCRIBE BEARING TREES OR OTHER OFFICIAL ACCESSORIES FOUND

ORIG. 18" FIR IS A 40' HIGH SNAG W/ DOUBLE HEALED BLAZES. BEARS N40°W, 20.5 ft.

ORIG. 16" FIR IS A 30' HIGH SHATTERED SNAG. SCRIBING, "1/4 SBT" IS VISIBLE (THIS TREE HAS OVER 12" OF OVERGROWTH OVER SCRIBES) BEARS N85E, 29.7 ft

PHOTO IDENTIFICATION DATA

Photo No. \_\_\_\_\_  
Filed At. \_\_\_\_\_  
Object Ident. \_\_\_\_\_  
Ident. By \_\_\_\_\_  
*Signature*

PLANE COORDINATE POSITION DATA

State \_\_\_\_\_ Zone \_\_\_\_\_  
X \_\_\_\_\_  
Y \_\_\_\_\_  
Estob. By \_\_\_\_\_  
*Agency*

DESCRIBE CORNER LOCATION RELATIVE TO NEAR-BY FEATURES, ALSO HOW TO REACH CORNER

*Signature* Dennis L. Gaylord      *Title* PLS 1636      *Division* \_\_\_\_\_      *Headquarters* \_\_\_\_\_      *Date* 7-15-82      7100-52 (3. 68)

**CORNER RECORD (PERPETUATION)**

**MONUMENT : DESCRIBE NEW MONUMENT SET, OR WORK DONE TO PRESERVE EXISTING MONUMENT**

**ACCESSORIES : DESCRIBE NEW BT's WITNESS OBJECTS ETC. ESTABLISHED, OR WORK DONE TO PRESERVE EXISTING EVIDENCE**

**Work Done By** \_\_\_\_\_ **Title** \_\_\_\_\_ **Date** \_\_\_\_\_ **State Registration No.** \_\_\_\_\_  
**or Agency** \_\_\_\_\_

**Certified Cor. Record Prepared ?** Yes No **Filed At:** \_\_\_\_\_ **Date** \_\_\_\_\_

**REMARKS**

**Index File No.**

**T.**

**R.**

**M.**

**Tract or Surv. No.**

**Cor.**

**12**

**13**