

USDA-FOREST SERVICE

Index File No. L-21

CORNER RECORD (SEARCH)

(Ref. FSM 7151.4)

Tract or Survey No. _____ Cor. No. _____

T 2N R. 37E


R.D. WALLA WALLA County UMATILLA

Merid. WILL

N.F. UMATILLA State OREGON

CORNER DIAGRAM

T2N R37E

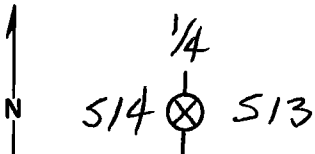

DESCRIBE CORNER MONUMENT FOUND

STONE - NO MARKS VISIBLE

DESCRIBE BEARING TREES OR OTHER OFFICIAL ACCESSORIES FOUND

ORIG 48" FIR IS NOW A BROKEN SNAG W/
 A SINGLE PARTLY HEALED BLAZE W/ SCRIBES
 "45" VISIBLE. ROOT HOLE FITS LOCATION OF ORIG.
 24" PINE. ORIG. 30" PINE LINE TREE 46.2 FT
 SOUTH IS LIVE W/ DOUBLE HEALED NOTCHES ON

PHOTO IDENTIFICATION DATA

Photo No. _____
 Filed At. _____
 Object Ident. _____
 Ident. By _____
 Signature

DESCRIBE CORNER LOCATION RELATIVE TO NEAR-BY FEATURES, ALSO HOW TO REACH CORNER

N & S SIDES. I PUT BT SIGNS ON FIR SNAG
 & THE LINE TREE. & A LOCATION POSTER ON 12"
 COTTONWOOD ON WEST SIDE OF ROAD 32 ABOUT
 500 FT. WEST OF CORNER, BT BEARS N80°E,
 21 LINKS. (13.86 FT.)

PLANE COORDINATE POSITION DATA

State _____ Zone _____
 X _____
 Y _____
 Estab. By _____
 Agency

Signature Dennis J. Gaylord Title _____ Division PLS 1636 Headquarters _____ Date 10-26-89 FS-7100-52 (3/68)

CORNER RECORD (PERPETUATION)

MONUMENT: DESCRIBE NEW MONUMENT SET, OR WORK DONE TO PRESERVE EXISTING MONUMENT

9

ACCESSORIES : DESCRIBE NEW BT'S WITNESS OBJECTS ETC. ESTABLISHED, OR WORK DONE TO PRESERVE EXISTING EVIDENCE

10

Work Done By _____ Title _____ Date _____ State Registration No. or Agency _____

Certified Cor. Record Prepared ? Yes No Filed At: _____ Date _____

11

REMARKS

12

Index File No. T. R. M. Tract or Surv. No. Cor. _____

13