

Form 874-9—Revised May, 1918

U. S. DEPARTMENT OF AGRICULTURE  
FOREST SERVICE

Unadilla NATIONAL FOREST

CORNERS OF THE PUBLIC SURVEY

T. 2 N R. 37 E W Mer.

Section Corner common to Sections  
24, and 25

Corner consists of a Stake (not) in place  
State condition 4" x 4" x 30"

Dimensions above ground \_\_\_\_\_ inches.  
Sketch grooves, letters, figures, or notches, on proper face or edge.

CARDINAL POSITION

DIAGONAL POSITION

—			
—			
—			

N W S E

<u>R37 E</u>	<u>Notched</u>		
<u>S24</u>	<u>wood</u>		

NW SW SE NE

Mound of \_\_\_\_\_ is located \_\_\_\_\_

Pits are located \_\_\_\_\_

Sketch markings of Bearing Trees (or Rocks) in proper box and fill blanks below, giving bearings from Corner to Trees and Distances in Links.

T 2 N  
R 37 E  
S 24



18 T



Species Y.P.  
Diameter 32"  
Bearing N 25 E  
Distance 25 ft

Do you believe this to be a genuine Land Office Corner? Yes

If not, why? \_\_\_\_\_

\_\_\_\_\_

Donald J. Tucker  
Signature.


9-23-30  
Date.

Forest Ranger  
Title.

T. 2 N R. 37 E. 11 Mer.

8-3027

(Make sketch of topography near Corner.)

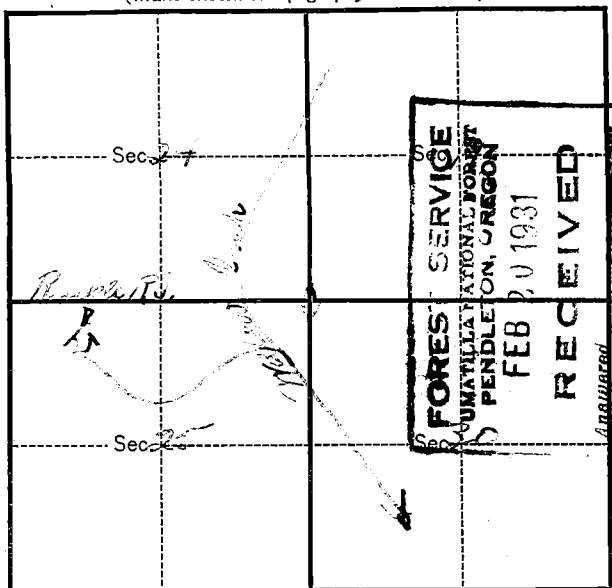

Metal Location Poster is on a 0.7  
tree 18 inches diameter, on the north  
side of corner  
from which this Corner bears One South  
1/2 chains distant:

Give any further facts which will aid in finding this  
Corner again.

On a small ridge which  
is part of the Ridge about  
1/2 to 1/4 mile west of  
corner.