

**OREGON CORNER RESTORATION FORM**

Section 2 Township 2S Range 31E  
 County Umatilla Date: April 8, 2011

Corner Designation: 2S31C17

Condition Report Only

Not found

Remonumented

Unrecorded

Surveyed in

Referenced out


Common quarter corner to sections 2 and 3, T2S, R31E, W.M., Umatilla County, Oregon.

Previous Renewals / Surveys, etc.

Corner originally set by Daniel Chaplin under contract No. 107 dated September 21, 1864. His record reads: Set stone 18x15x6 for 1/4 Sec. Cor.


Monument and Accessories found: ( condition and source )

I found a basalt stone 18x15x5 in a mound of stone. The surface of the stone was crumbly and had been wire brushed by Dennis Gaylord in about 1998. I could find no visible marks but the mound was distinct.

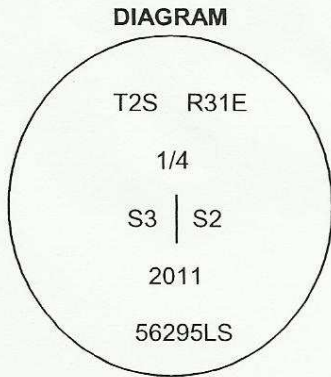

⊗ = Set AL Cap  
 • = Rebar References

SKETCH

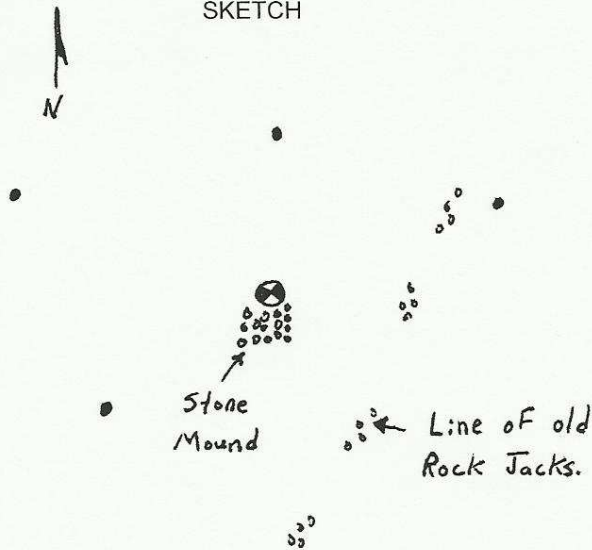

**MONUMENT (S) AND ACCESSORIES SET (Procedures and Description)**

At the position of the original stone the soil was approximately 3 inches deep. I drove a 1"x24" iron rebar into the bedrock with a 2" aluminum cap attached stamped as shown in the diagram above and build a mound of stone 4' diameter and 2' high south of the monument.

For references, I set four 5/8" by 24" rebars with 1.25" orange plastic caps stamped WTS and 56295LS as described below:

- an iron rebar bears N67°53'24"W, 193.88 feet;
- an iron rebar bears N02°46'43"W, 103.41 feet;
- an iron rebar bears N65°20'08"E, 123.58 feet;
- an iron rebar bears S64°17'33"W, 77.18 feet;

The monument and references were tied using a Trimble R7/R8 RTK GPS system.

Location and comments

Compass Declination

Surveyors Seal

RECEIVED BY:  
Umatilla County Surveyor  
 Date: \_\_\_\_\_  
 Rec'd By: \_\_\_\_\_  
 No. 11-112-c

Firm / Agency  
 Witness Tree Surveying  
 Address  
 P.O. Box G  
 Pilot Rock, OR 97868  
 Party Chief  
 Stephen K, Haddock

REGISTERED  
 PROFESSIONAL  
 LAND SURVEYOR

*Stephen K. Haddock*

OREGON  
 JULY 9, 2001  
 STEPHEN K. HADDOCK  
 56295LS

RENEWAL DATE 6-30-13