

OREGON CORNER RELOCATION FORM

Section 8 Township 2S Range 32E
 County Umatilla Date: April 5, 2007

Corner Designation: 2S32E5

Corner to sections 5, 6, 7, and 8, T2S, R32E, W.M., Umatilla County, Oregon.


Previous Renewals / Surveys, etc.

Corner originally set by Daniel Chaplin under contract No. 107 dated September 21, 1864. His record reads: Set stone, 18 x 8 x 8 for cor. to secs. 5, 6, 7 & 8.

Condition Report Only
 Not found
 Remonumented
 Unrecorded
 Surveyed in
 Referenced out

Monument and Accessories found: (condition and source)

I found a basalt stone approximately 12 x 12 x 15" above the ground in a 3' diameter mound of stone. The stone was marked "x" on top. The mound lies approximately 20' east of a north-south fence line on the east side of a small gully. The stone dimensions given are approximate only as I only visited the corner 1 time to measure to it. The stone is much larger than record and is of unknown origin.

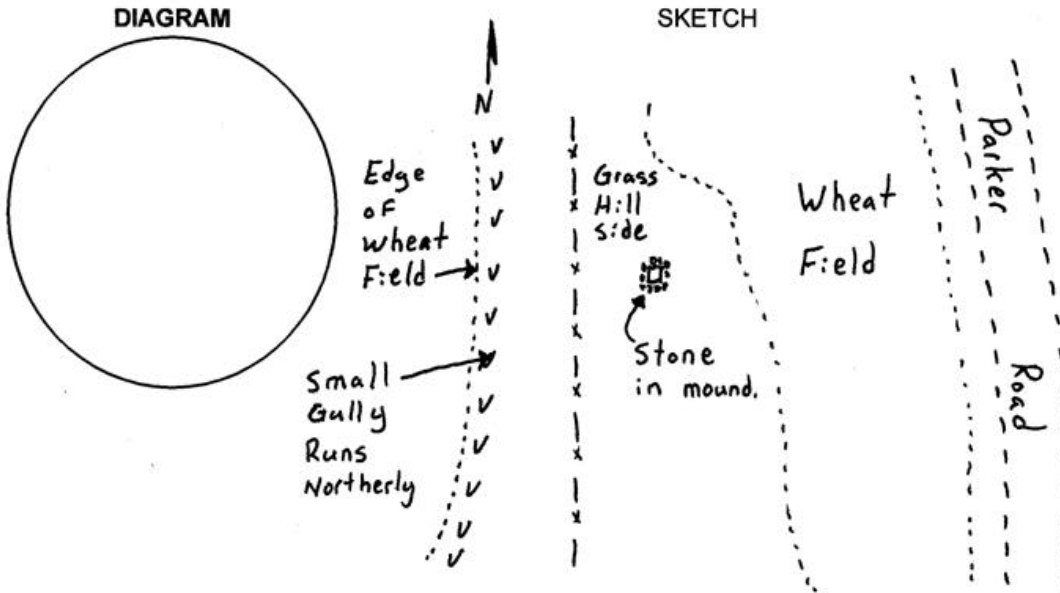

MONUMENT (S) AND ACCESSORIES SET (Procedures and Description)
 None. This is a condition report only.

The monument was tied using a Trimble R7/R8 RTK GPS.

Location and comments

Compass Declination

Surveyors Seal

RECEIVED BY:
Umatilla County Surveyor
 Date: 6-07
 Rec'd By: FK
 No. 07-169-C

Firm / Agency
 Witness Tree Surveying
 Address
 P.O. Box G
 Pilot Rock, Or. 97868
 Party Chief
 Stephen K, Haddock

REGISTERED
 PROFESSIONAL
 LAND SURVEYOR

Stephen K. Haddock

OREGON
 JULY 9, 2001
 STEPHEN K. HADDOCK
 56295LS

RENEWAL DATE 6-30-07