

**OREGON CORNER RESTORATION FORM**

Section 29 Township 2S Range 32E  
 County Umatilla Date: April 9, 2016

Corner Designation: 2S32T5

Condition Report Only  
 Not found

Quarter corner to sections 29 and 30, T2S, R32E, W.M.  
 Umatilla County, Oregon.

   x Remonumented  
   Unrecorded  
   x Surveyed in  
   x Referenced out


Previous Renewals / Surveys, etc.

The corner was originally set by Daniel Chaplin under contract No. 107 dated September 21, 1864. His record reads: Set stone 15 x 12 x 6 for 1/4 sec cor. John Arnold, under contract No. 551 dated March 19, 1890 reports "set temporary point" but did not report setting a final monument.

Monument and Accessories found: ( condition and source )

None. The position falls in a steep talus rock slide below a small bluff.


**DIAGRAM**

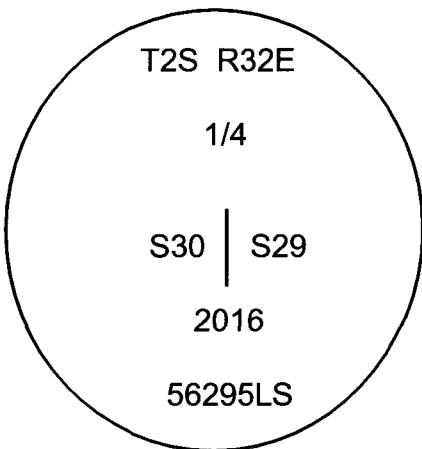

⊗ = Brass Cap

• = Rebar Reference

**SKETCH**

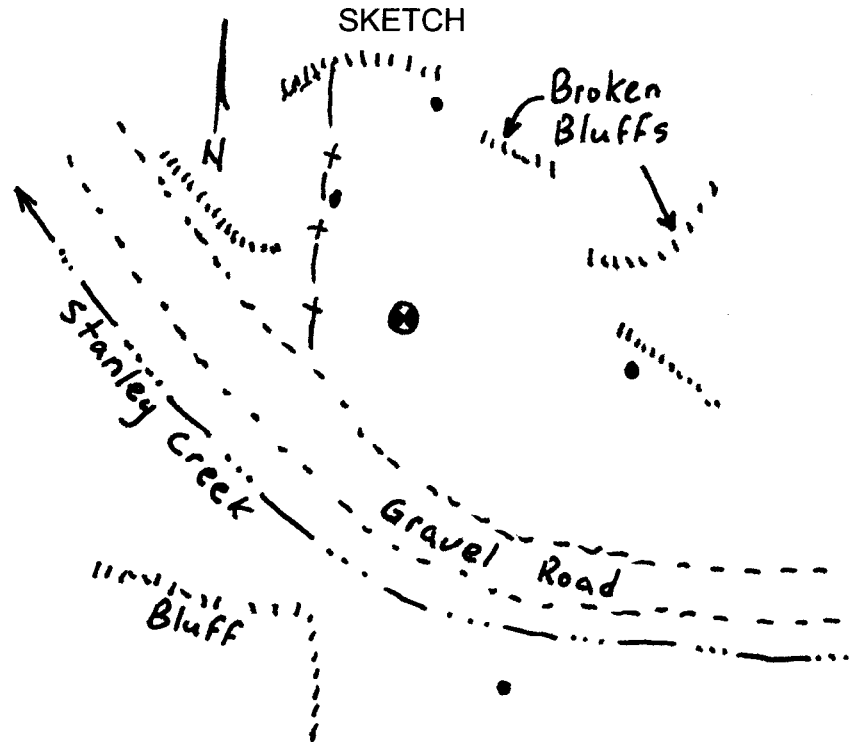

**MONUMENT (S) AND ACCESSORIES SET (Procedures and Description)**

I set a 2 1/4" brass cap on a 1 1/2" x 30" galvanized steel pipe at the proportioned point. The cap was stamped as shown in the diagram above.

For references I set four 5/8" x 24" iron rebars with 1 1/8" orange plastic caps stamped WTS and 56295LS as described below:

- an iron rebar bears N21°14'16"W, 37.95 feet under the existing fence;
- an iron rebar bears N09°30'49"E, 61.83 feet at the foot of a small bluff;
- an iron rebar bears S76°24'53"E, 88.98 feet at the foot of a small bluff;
- an iron rebar bears S06°40'26"E, 161.94 feet approximately 20 feet south of Stanley Creek;

These references were set and tied using a Trimble R7/R8 RTK GPS

Location and comments

Compass Declination

Surveyors Seal

**RECEIVED BY:**

Umatilla County Surveyor

Date: 6/20/2016

Rec'd By: Day

No. 16-051-B

Firm / Agency  
 Witness Tree Surveying  
 Address  
 P.O. Box G  
 Pilot Rock, Or. 97868  
 Party Chief  
 Stephen K, Haddock

REGISTERED  
 PROFESSIONAL  
 LAND SURVEYOR

*Stephen K. Haddock*

OREGON  
 JULY 9, 2001  
 STEPHEN K. HADDOCK  
 56295LS

RENEWS: 6-30-17