

OREGON CORNER RESTORATION FORM

Section 17 Township 2S Range 33E
 County Umatilla Date: October 30, 2002

Corner Designation: 2S33J9

Condition Report Only
 Not found
 Remonumented
 Unrecorded
 Surveyed in
 Referenced out


Corner to sections 8, 9, 16, and 17, T2S, R33E,
 W.M., Umatilla County, Oregon.

Previous Renewals / Surveys, etc.

Corner originally set by John C. Arnold under contract #551 dated March 19, 1890.
 His record reads: Set basalt stone, 15 x 10 x 10 ins., 10 ins. in ground for cor. to secs. 8, 9, 16 & 17, marked 4 notches on S., and 4 notches on E. and raised a mound of stone, 2 ft. high by 4 1/2 ft. base over stone on S. hillside. Pits impracticable. John Horns house bears S.E. about 15.00 chains.

Monument and Accessories found: (condition and source)

The original stone, plainly chisled, loose in a mound of stone. Mr. Dennis Gaylord used this corner for a water rights application and stated that he built the mound of stone around the corner stone in it's original position.

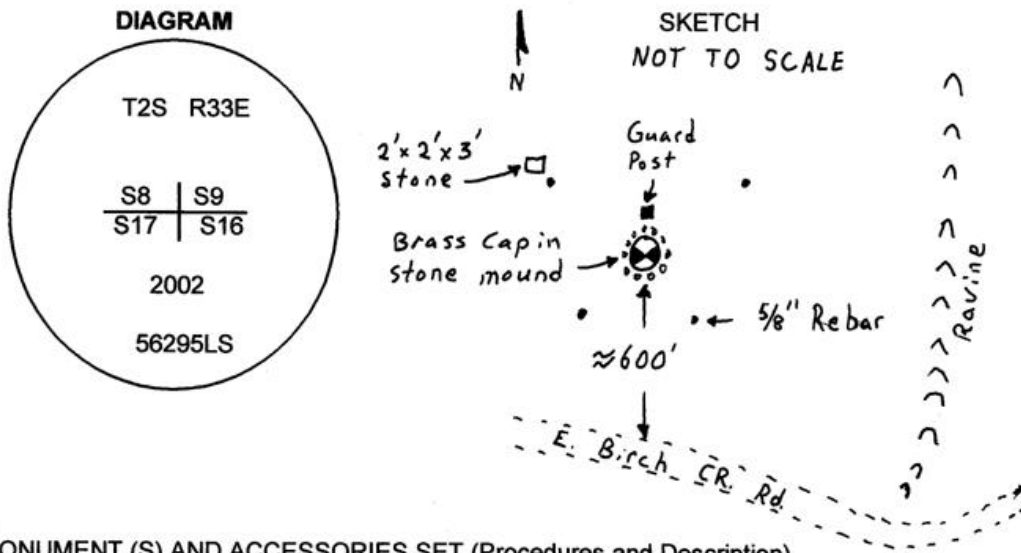

MONUMENT (S) AND ACCESSORIES SET (Procedures and Description)

Set a 1 1/2" x 30" galvanized iron pipe with a 2 1/4" brass cap stamped as shown in the diagram 15" in the ground at the position of the original stone. Buried the stone along the east side of the monument. Attached a county monument sign to a 5' steel guard post.

For references, I set four, 5/8" by 24" rebars with 1.25" orange plastic caps attached, stamped WTS and 56295LS, as described below:

- an iron rebar bears N60°08'48"W, 121.20 feet at the S.E. corner of a 2' x 2' x 3' stone in place;
- an iron rebar bears S43°01'57"W, 22.10 feet;
- an iron rebar bears S19°56'55"E, 38.36 feet;
- an iron rebar bears N76°28'03"E, 25.88 feet;

The monument and references were tied using a LIECA system 300 RTK GPS.


Location and comments

Compass Declination


Surveyors Seal

RECEIVED BY:
 Umatilla County Surveyor
 Date: 2-03
 Rec'd By: RK
 No. 03-24-B

Firm / Agency
 Haddock Surveying
 Address
 P.O. Box 1574
 Pendleton, Or. 97801
 Party Chief
 Stephen K, Haddock

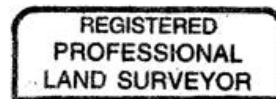

Stephen K. Haddock

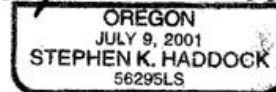

RENEWAL DATE 6-30-03