

OREGON CORNER STORAGE FORM

Section 28 Township 2S Range 33E
 County Umatilla Date: June 9, 2000

Corner Designation: 2S33R11

Common quarter corner to sections 21 and 28, T2S, R33E, W.M., Umatilla County, Oregon.

Condition Report Only
 Not found
 Remonumented
 Unrecorded
 Surveyed in
 Referenced out

Previous Renewals / Surveys, etc.


Corner originally set by John C. Arnold under contract #551 dated March 19, 1890.

His record reads: A basalt stone, in place 18 x 12 x 10 ins., above ground for 1/4 section cor. marked 1/4 on N. face, X at exact cor. point. Raised a mound of stone 1 1/2 ft. high by 3 1/2 ft. base about the stone, from which:

A pine, 36 ins. diam., brs. W. 65 lks. dist. marked 1/4 S BT.

Monument and Accessories found: (condition and source)

The original BT completely healed. I opened the blaze which was about 6 feet in the air and the scribing was plainly visible. The slope has eroded badly and there were no stones at the corner location.

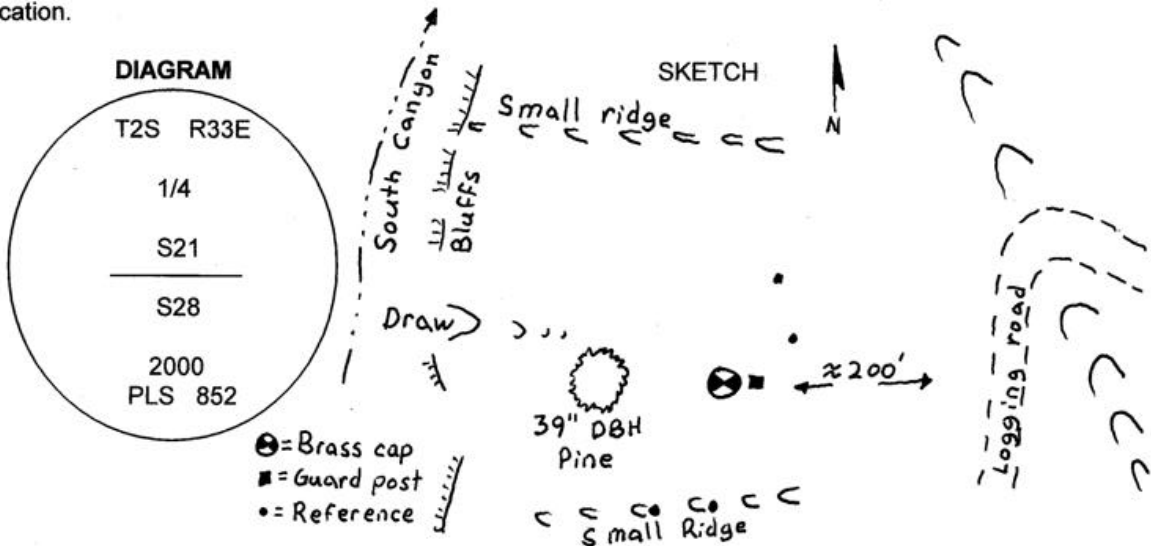

MONUMENT (S) AND ACCESSORIES SET (Procedures and Description)

Set a 1 1/2" x 30" galvanized iron pipe with a 2 1/4" brass cap stamped as shown in the diagram above at the position of the original stone. Buried the stone along side. Set a 6' steel post with a county monument sign attached along side.

For references, I set four 5/8" by 24" rebars with 2.5" red plastic caps stamped ORLS 852, WALS 13922 and HADDOCK SURVEYING as described below:

- an iron rebar bears N36°27'54"E, 48.63 feet in a small rock point;
- an iron rebar bears N52°02'28"E, 31.56 feet;
- an iron rebar bears S66°03'44"W, 67.71 feet;
- an iron rebar bears S16°39'27"W, 65.21 feet;

The monument and references were tied using a LIECA system 300 RTK GPS.

Location and comments

Compass Declination

Surveyors Seal

RECEIVED BY:
 Umatilla County Surveyor
 Date: 7-00
 Rec'd By: JK
 No. 00-156-C

Firm / Agency
 Haddock Surveying
 Address
 P.O. Box 1574
 Pendleton, Or. 97801
 Party Chief
 Stephen K, Haddock

REGISTERED
 PROFESSIONAL
 LAND SURVEYOR

David L. Haddock

OREGON
 JULY 12, 1966
 DAVID L. HADDOCK
 852