

OREGON CORNER RESTORATION FORM

Section 25 Township 2S Range 33E
 County Umatilla Date: June 14, 2000

Corner Designation: 2S33R23

Quarter corner to sections 24 and 25, T2S, R33E,
 W.M., Umatilla County, Oregon.

Condition Report Only
 Not found
 Remonumented
 Unrecorded
 Surveyed in
 Referenced out

Previous Renewals / Surveys, etc.

Corner originally set by John C. Arnold under contract No. 551 dated March 19, 1890.



His record reads: Set basalt stone 18 x 12 x 8 ins., 12 ins. in ground, for 1/4 section corner, marked 1/4 on N. face. Dug pits 18 x 18 x 12 ins. E & W of stone 5 1/2' dist. Raised a mound of earth 2 ft. high x 4 ft. base over cor. from which:

A fir, 8 ins. diam., brs. N. 15 lks. dist., marked 1/4 S BT;

A fir, 10 ins. diam., brs. S. 26 lks. dist., marked 1/4 S BT;

Monument and Accessories found: (condition and source)

The record stone, plainly chisled 1/4 and firmly in place. The area had been logged and there were fir stumps in the general area of the BT's.

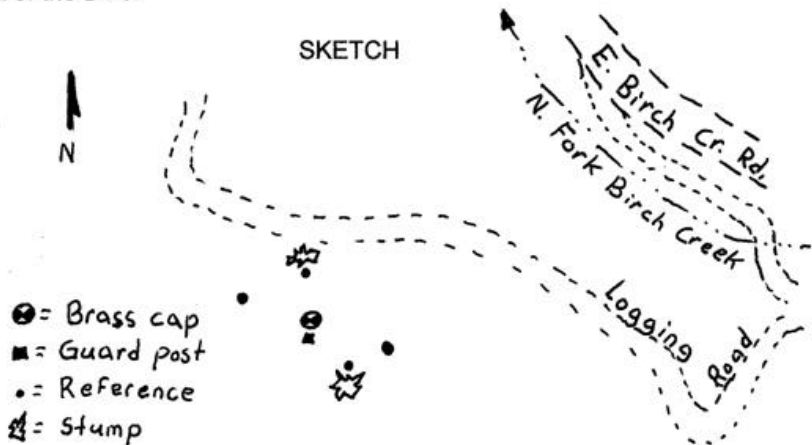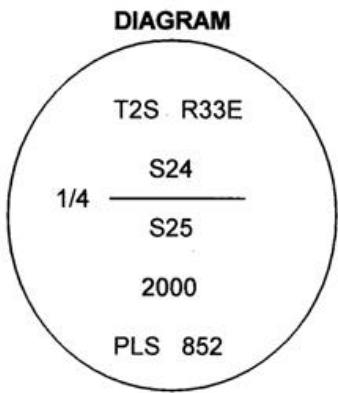

MONUMENT (S) AND ACCESSORIES SET (Procedures and Description)

Set a 1 1/2" x 30" Galvanized Iron pipe with a 2 1/4" brass cap stamped as shown in the diagram above at the position of the original stone and buried the stone along side. Set a 6' steel post with a county monument sign attached along side.

For references, I set four 5/8" by 24" rebars with 2.5" red plastic caps stamped ORLS 852, WALS 13922 and HADDOCK SURVEYING as described below:

- an iron rebar bears N67°51'02"W, 20.43 feet;
- an iron rebar bears N08°51'58"W, 10.31 feet on the S. face of the apparent BT stump;
- an iron rebar bears S56°24'56"E, 28.85 feet;
- an iron rebar bears S33°46'32"E, 23.85 feet on the N. face of the apparent BT stump;

The monument and references were tied using a Geodimeter System 600 Electronic Total Station from control established with a LIECA System 200 static GPS.

Location and comments

Compass Declination

Surveyors Seal

RECEIVED BY:
Umatilla County Surveyor
 Date: 7-00
 Rec'd By: KF
 No. 00-156-C

Firm / Agency
 Haddock Surveying
 Address
 P.O. Box 1574
 Pendleton, Or. 97801
 Party Chief
 Stephen K, Haddock

