

OREGON CORNER RESTORATION FORM

Section 29 Township 2S Range 33E
 County Umatilla Date: June 12, 2000

Corner Designation: 2S33R7

Quarter corner to sections 20 and 29, T2S, R33E,
 W.M., Umatilla County, Oregon.


Condition Report Only
 Not found
 Remonumented
 Unrecorded
 Surveyed in
 Referenced out

Previous Renewals / Surveys, etc.

Corner originally set by John C. Arnold under contract No. 551 dated March 19, 1890.
 His record reads: Set basalt stone 14 x 8 x 6 ins., 8 ins. in ground, for 1/4 section corner, marked 1/4 on north face. Raised a mound of stone 1 1/2' high x 3 1/2 foot base over corner on W. side of mountain.

Monument and Accessories found: (condition and source)

A large mound of stones with a record dimension, unmarked, stone firmly in place in the mound.

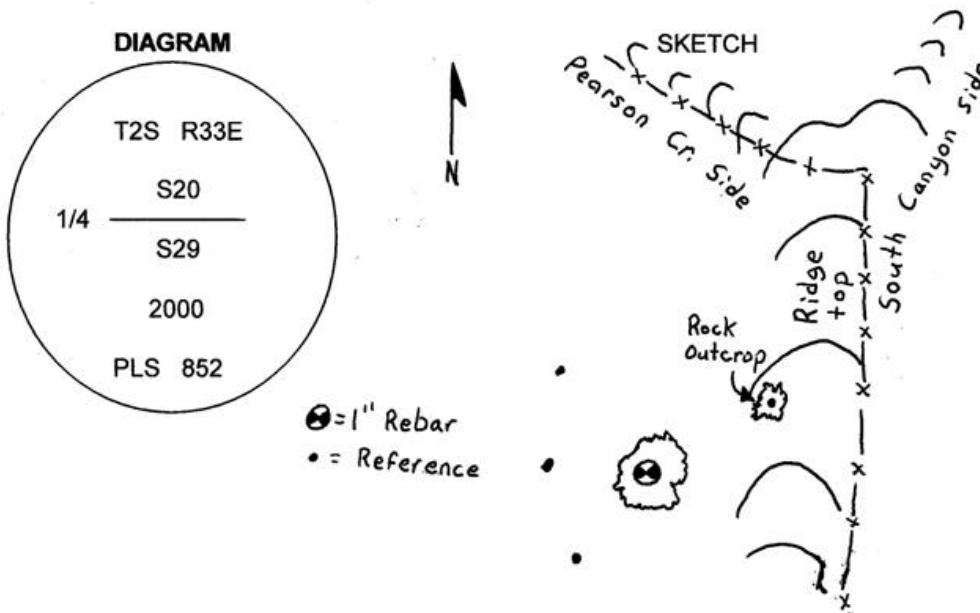

MONUMENT (S) AND ACCESSORIES SET (Procedures and Description)

Set a 1" x 24" Iron Rebar with a 2" aluminum cap stamped as shown in the diagram above in the original mound and burried the stone along side.

For references, I set four 5/8" by 24" rebars with 2.5" red plastic caps stamped ORLS 852, WALS 13922 and HADDOCK SURVEYING as described below:

- an iron rebar bears N55°11'47"W, 45.43 feet;
- an iron rebar bears N67°09'13"E, 80.30 feet in a small rock outcrop;
- an iron rebar bears S69°38'01"W, 40.96 feet;
- an iron rebar bears S19°24'09"W, 51.85 feet;

The monument and references were tied using a LIECA system 300 RTK GPS.

Location and comments

Compass Declination

Surveyors Seal

RECEIVED BY:
 Umatilla County Surveyor
 Date: 7-00
 Rec'd By: SK
 No. 00-156-C

Firm / Agency
 Haddock Surveying
 Address
 P.O. Box 1574
 Pendleton, Or. 97801
 Party Chief
 Stephen K, Haddock



David L. Haddock

