

**OREGON CORNER RESTORATION FORM**

Section 29 Township 2S Range 33E  
 County Umatilla Date: June 12, 2000

Corner Designation: 2S33T5

Common quarter corner to sections 29 and 30, T2S, R33E,  
 W.M., Umatilla County, Oregon.



Condition Report Only  
 Not found  
 Remonumented  
 Unrecorded  
 Surveyed in  
 Referenced out

Previous Renewals / Surveys, etc.

Corner originally set by John C. Arnold under contract #551 dated March 19, 1890.  
 His record reads: Set basalt stone, 12 x 10 x 5 ins., 8 ins. in ground for 1/4 section cor. marked 1/4 on W. face, raised a mound of stone 1 1/2 ft. high by 3 1/2 ft. base over cor. on W. face of hill.

Monument and Accessories found: ( condition and source )

The original stone, settled over on it's west face with a mound of one other stone. The remaining wooden posts from a removed fence indicate an E - W fence was near this location.

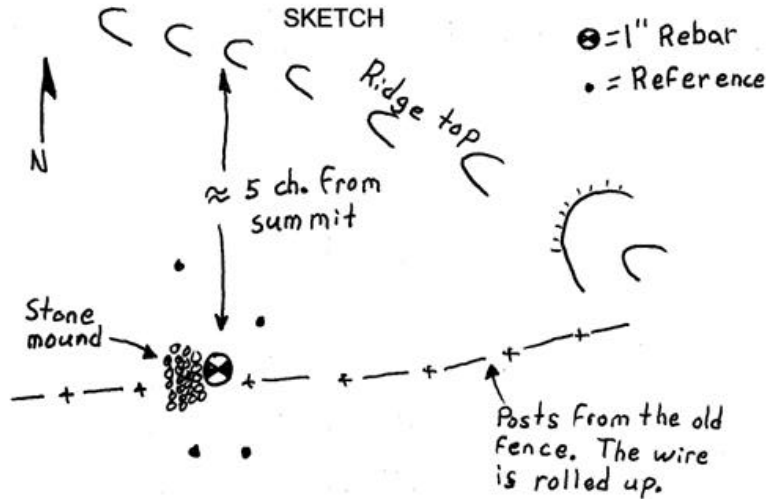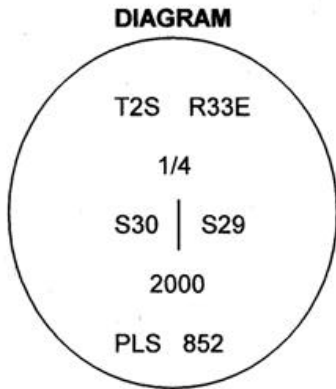

**MONUMENT (S) AND ACCESSORIES SET (Procedures and Description)**

Set a 1" x 24" iron rebar 2" aluminum cap stamped as shown in the diagram above at the position of the original stone. Buried the stone along side. Set a 6" steel post with a county monument sign attached along side. Built a stone mound on the west side of the corner.

For references, I set four 5/8" by 24" rebars with 2.5" red plastic caps stamped ORLS 852, WALS 13922 and HADDOCK SURVEYING as described below:

- an iron rebar bears N26°29'58"W, 40.65 feet;
- an iron rebar bears N36°29'57"E, 22.88 feet;
- an iron rebar bears S19°50'01"W, 29.38 feet;
- an iron rebar bears S29°02'11"E, 30.41 feet;

The monument and references were tied using a LIECA system 300 RTK GPS.

Location and comments

Compass Declination

Surveyors Seal

RECEIVED BY:  
Umatilla County Surveyor  
 Date: 7-00  
 Rec'd By: KK  
 No. 00-156-C

Firm / Agency  
 Haddock Surveying  
 Address  
 P.O. Box 1574  
 Pendleton, Or. 97801  
 Party Chief  
 Stephen K, Haddock

