

Index
File No. _____

CORNER RECORD (SEARCH)

(Ref. FSM 7151.4)

Tract or
Survey No. UIR

Cor.
No. 62M,P.

T 25 R. 34 E

R.D. _____ County UMATILLA

Merid. WILLAMETTE

N.F. UMATILLA State OREGON

CORNER DIAGRAM



*UIR
62M*

DESCRIBE CORNER MONUMENT FOUND

2 1/2" DIAM. BRASS CAP SET ON A 2" O.D. IRON PIPE
EXTENDING 6" OUT OF GROUND.
CAP MKD PER SKETCH

T25 R34E

*UIR
62M
1917*

DESCRIBE BEARING TREES OR OTHER OFFICIAL ACCESSORIES FOUND

8" D.B.H. FIR SNAG (6"), N. 23° W., 13 LKS., W/SCRIBES M62 IN
UPPER BLAZE, LOWER BLAZE HEALED.

21" D.B.H. (18") DOUGLAS FIR, S. 65° 30' W., 21 LKS., W/SCRIBE
VISIBLE IN NEARLY HEALED UPPER BLAZE, LOWER BLAZE
HEALED.

PHOTO IDENTIFICATION DATA

Photo No. _____

Filed At. _____

Object Ident. _____

Ident. By _____

Signature

PLANE COORDINATE POSITION DATA

State _____ Zone _____

X _____

Y _____

Estab. By _____

Agency

DESCRIBE CORNER LOCATION RELATIVE TO NEAR-BY FEATURES, ALSO HOW TO REACH CORNER

TAKE ROAD 21 TO WEST LINE S. 31, T. 25, R. 35E, TAKE
ROAD NORTH 1.25 MI. TO 1/4 ^{S. 25} _{S. 36}, THEN GO WEST 1522'
TO CLOSING CORNER, THEN S. 20° W., 491' TO MILE
POST.

Signature

Title

Division

Headquarters

Date

FS-7100-52 (3/68)

Clayton J. Martin

LAND SURVEYOR

7-9-85

CORNER RECORD (PERPETUATION)

MONUMENT: DESCRIBE NEW MONUMENT SET, OR WORK DONE TO PRESERVE EXISTING MONUMENT

RAISED STONE MOUND. SET STEEL POSTS W/SIGNS ATTACHED 4'± N. & S.

9

ACCESSORIES : DESCRIBE NEW BT'S WITNESS OBJECTS ETC. ESTABLISHED, OR WORK DONE TO PRESERVE EXISTING EVIDENCE

10" D.B.H. WHITE FIR, N. 57° W., 12.2', SCRIBED 62 MUIR BT. SET BRASS WASHER MKD. RPLS 1910 BTWN. B & T.

ALL BT'S. @ THIS COR. HAVE B.T. TAGS, ATTN. SIGNS, BANDS & FACES PAINTED RED.

10

Work Done By G.J. MARTIN Title LAND SURVEYOR Date 7-9-85 State Registration No. L 5 1910
or Agency

Certified Cor. Record Prepared? Yes No Filed At: Date

11

REMARKS

Index File No. T. 2 S R. 34 E M. WILLAMETTE Tract or Surv. No.

Cor. 13

UIR
62M

Index

File No.

CORNER RECORD (SEARCH)

(Ref. FSM 7151.4)

Tract or

Survey No.

UIR

Cor.

No.

MP 62

T 2S R. 34E

R.D. UKIAH


County UNION

Merid. WILL

N.F. UMATILLA

State OREGON

CORNER DIAGRAM

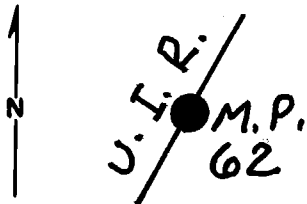

DESCRIBE CORNER MONUMENT FOUND

BRASS CAPPED IRON PIPE SOLIDLY SET WITH CAP 8" ABOVE GROUND.

DESCRIBE BEARING TREES OR OTHER OFFICIAL ACCESSORIES FOUND

ORIG. 6" FIR IS A SNAG WITH SCRIBES VISIBLE ON UPPER BLAZE, LOWER BLAZE IS HEALED, BEARS N23°W, 13 LKS.

ORIG. 18" FIR IS LIVE, SCRIBES ARE VISIBLE ON UPPER BLAZE, LOWER BLAZE IS HEALED, BEARS S65 1/2° W, 21 LKS.

DESCRIBE CORNER LOCATION RELATIVE TO NEAR-BY FEATURES, ALSO-HOW TO REACH CORNER

PHOTO IDENTIFICATION DATA

Photo No.

Filed At.

Object Ident.

Ident. By

Signature

PLANE COORDINATE POSITION DATA

State Zone

X

Y

Estab. By

Agency

Signature

Title

Division

Headquarters

Date

7100-52-(3,68)

Dennis L. Gaylord

PLS 1636

5-24-84

CORNER RECORD (PERPETUATION)

MONUMENT: DESCRIBE NEW MONUMENT SET, OR WORK DONE TO PRESERVE EXISTING MONUMENT

ACCESSORIES : DESCRIBE NEW BT's WITNESS OBJECTS ETC. ESTABLISHED, OR WORK DONE TO PRESERVE EXISTING EVIDENCE

Work Done By _____ Title _____ Date _____ State Registration No. _____
or Agency _____

Certified Cor. Record Prepared ? Yes No Filed At: _____ Date _____

REMARKS

Index File No. T. R. M. Tract or Surv. No. Cor.