

**OREGON CORNER RESTORATION FORM**

Section 19 Township 2S Range 34E  
 County Umatilla Date: July 1st, 2006

Corner Designation: 2S34R3

Quarter corner common to sections 19 and 30, T2S, R34E,  
 W.M., Umatilla County, Oregon.


Previous Renewals / Surveys, etc.

Corner originally set by James Currin and James Noland under special instruction dated May 4th, 1887. Their record reads: Set stone, 7 x 8 x 10 ins., 6 ins. in ground, for 1/4 sec. cor., marked 1/4 on N. face, over which, I raised mound of stone, 18 ins. high with 3 1/2 foot base.

Condition Report Only  
 Not found  
 Remonumented  
 Unrecorded  
 Surveyed in  
 Referenced out


Monument and Accessories found: ( condition and source )  
 None.

**DIAGRAM**

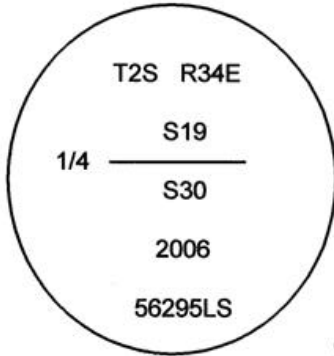

⊗ = Brass Cap  
 • = Rebar Reference

**SKETCH**

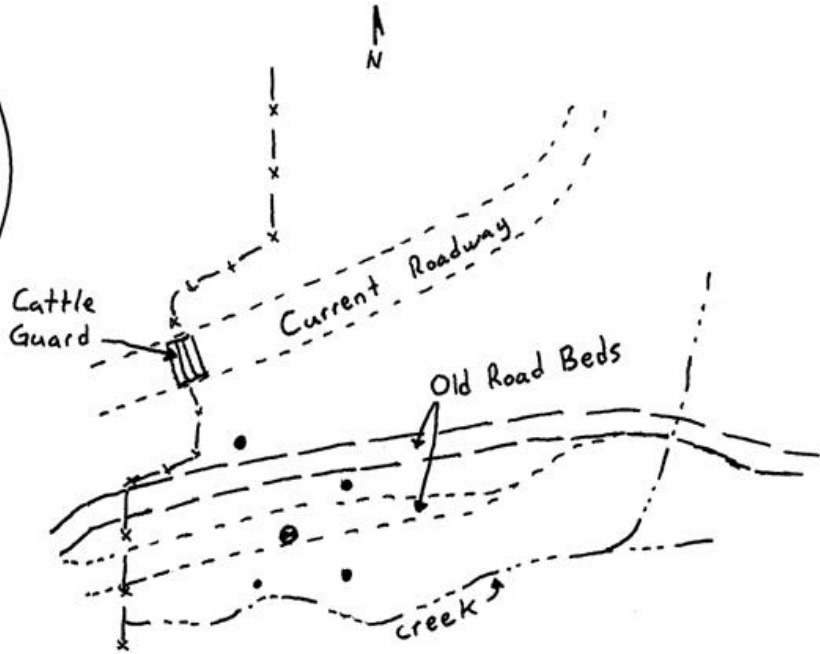

**MONUMENT (S) AND ACCESSORIES SET (Procedures and Description)**

At the proportionate point I set a 1 1/2" x 30" galvanized iron pipe with a 2 1/4" brass cap attached stamped as shown in the diagram above. I made a collar of stone around the cap.

For references, I set four 5/8" by 24" rebars with 1.25" orange plastic caps stamped WTS and 56295LS as described below:

- an iron rebar bears S33°41'00"W, 14.54 feet;
- an iron rebar bears S87°25'19"E, 26.07 feet;
- an iron rebar bears N23°05'34"E, 27.93 feet;
- an iron rebar bears N27°18'28"W, 50.81 feet;

The monument and references were tied using a Trimble R7/R8 RTK GPS.

Location and comments

Compass Declination

Surveyors Seal

RECEIVED BY:  
Umatilla County Surveyor  
 Date: 7-06  
 Rec'd By: KK  
 No. 06-471-B

Firm / Agency  
 Witness Tree Surveying  
 Address  
 P.O. Box G  
 Pilot Rock, Or. 97868  
 Party Chief  
 Stephen K, Haddock

REGISTERED  
 PROFESSIONAL  
 LAND SURVEYOR

*Stephen K. Haddock*

OREGON  
 JULY 9, 2001  
 STEPHEN K. HADDOCK  
 56295LS

RENEWAL DATE 6-30-07