

Form 874-9—Revised May, 1918

U. S. Department of Agriculture
FOREST SERVICE

UMETILLA NATIONAL FOREST

CORNERS OF THE PUBLIC SURVEY

T. 25 R. 34E W.M. Mer.

Section Corner common to Sections

26, 27, 34, and 35

Corner consists of a pile of rocks sk. in place

State condition sk mostly rotted

Dimensions above ground 3" x 3" x 24" inches

Sketch grooves, letters, figures, or notches, on proper face or edge.

CARDINAL POSITION

DIAGONAL POSITION

--	--	--	--

<u>527</u>		<u>535</u>	<u>52725</u>
------------	--	------------	--------------

N W S E

NW SW SE NE

Mound of rock is located

Pits are located

Sketch markings of Bearing Trees (or Rocks) in proper box and fill blanks below, giving bearings from Corner to Trees and Distances in Links.

<u>9</u>	<u>10</u>	<u>10</u>	<u>10</u>

Species

Diameter

Bearing

Distance


Do you believe this to be a genuine Land Office Corner? Yes

If not, why?

Walter Schuster
(Signature)
Asst. Forest Ranger
(Title)
9/18/39
(Date)

T. 25 R. 34 E. W.M. Mer.

(Make sketch of topography near Corner)

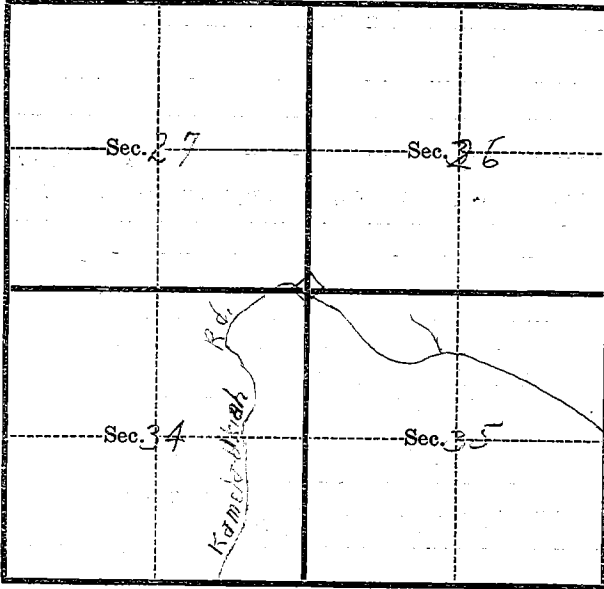

Metal Location Poster is on a Lodged pole Pine
tree 8 inches diameter, on the East
side of _____
from which this Corner bears West
_____ 1.0 chains distant.

Give any further facts which will aid in finding this
Corner again.

Corner is 20' N.E. of
Kemp's Mill Road in L.P.
stands visible from road
line crossing marked with X