


LAND CORNER RECORD

1. T. 2 S R. 34 E No. W-16 Cor. 1/16 Mer. Will State OREGON (Rectangular) N. F. WALLOWA-WHITMAN Dist. LA GRANDE

2. Corner Status

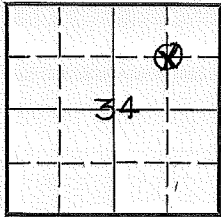

3. Original Description \_\_\_\_\_ Vol. \_\_\_\_\_ Page \_\_\_\_\_ Where Recorded \_\_\_\_\_

4. Description of Corners:

5. Investigation Notes: 1/16 COR. FOUND. 38 CHS. (25') SOUTH OF  
E of S214

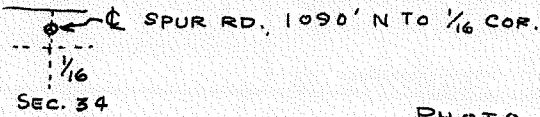


PHOTO IDENTIFIED

7. Photo Identification

Photo No. UBM-0 6C-24

Ident. By: \_\_\_\_\_

8. Plane Coordinate Position Data

State \_\_\_\_\_ Zone \_\_\_\_\_

X \_\_\_\_\_

Y \_\_\_\_\_

Estab. By \_\_\_\_\_

Field Book No. \_\_\_\_\_

Where Filed \_\_\_\_\_

9. Evaluation

Authentic X

Needs Verif. NO Monument

Re-estab. X Survey

Land Status \_\_\_\_\_

6. Signed \_\_\_\_\_ Title \_\_\_\_\_ Date \_\_\_\_\_

PERPETUATION RECORD

10. Monument:

11. Accessories

12. Set By _____ Title _____ License _____ Agency _____ Date _____	13. Recorded By _____ Volume _____ Page _____ (Agency) (Date) (City) (County) (State)
---	---

14. Remarks: