


**CERTIFIED RECORD OF LAND CORNER MONUMENTATION**

**HISTORY OF ORIGINAL CORNER ESTABLISHED:**

Corner originally established by Rufus S Moore under GLO Contract No. 451, dated June 12, 1882. Surveyor General field notes state:

T 2 S R 35 E E-11

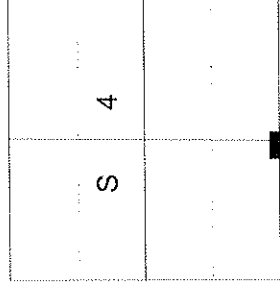

Set a basalt stone 14x10x8 ins. 10 ins. in the ground for ¼ sec. cor. marked ¼ on W. face, from which:  
A fir 26 ins. in diam bears N32° E 73 lks. dist. marked ¼ S.B.T.  
A fir 3 ins. in diam bears S35° W 62 lks. dist. marked ¼ S.B.T.

Corner brought to county standard from a found bearing tree in 1995 by Dennis L. Gaylord. Umatilla County monumentation record 95-209-R states:

I find a mound of stone at the corner point. One stone is about record size, but has no visible marks, from which:  
A 36" Douglas-fir, with scribes visible on a previously opened blaze, bears N32°E, 48.2 ft.  
At the exact corner point as determined by reference to the remaining original bearing tree, I set a 1" x 30" iron pipe 12" into the ground to bedrock. I build a mound of stones around the pipe to the cap. A 2¼" brass cap attached is marked as shown, from which:

- A 14" Douglas-fir scribed "1/4 S9 BT", bears S18° 30'E, 106.4 feet.
- A 9" Douglas-fir scribed "1/4 S9 BT", bears S48° 30'E, 42.1 feet.
- A 11" Douglas-fir scribed "1/4 S9 BT", bears S46° 30'E, 92.5feet.

**DESCRIPTION OF CORNER EVIDENCE FOUND:**

Found a 1" iron pipe with 2¼" brass cap marked as shown 15" above ground in a 3' mound of stone from which:

- A 16" Douglas fir bears South 18° East a dist. of 106.40 ft., alive and vigorous with healed blaze.
- An 11" Douglas fir bears South 48° West a dist. of 42.10 ft., alive and vigorous with healed blaze.

**DESCRIPTION OF MONUMENT AND ACCESSORIES I ESTABLISHED TO PERPETUATE THE ORIGINAL LOCATION OF THIS CORNER:**


From the iron pipe monument,

**NEW BEARING TREES:**

A 5" Ponderosa pine bears North 7° East a dist. of 66.60 ft., marked "1/4 S4 BT".

A 4" Ponderosa pine bears North 59° West a dist. of 37.93 ft., marked "X BT"

I hereby certify that the corner was perpetuated on September 5, 2018.  
Witness: Kyle A. Tucker, Ryan Skeen

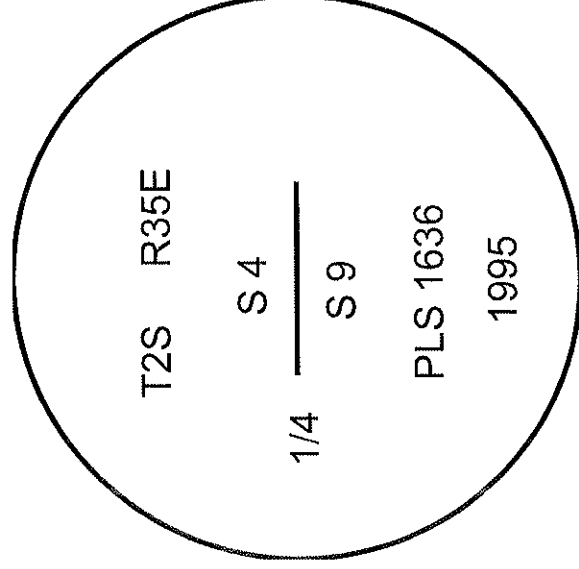

REGISTERED  
PROFESSIONAL  
LAND SURVEYOR

OREGON  
June 2, 2010  
JEFFREY S. HSU  
83571

Renewal Date: June 30, 2019

I used a steel tape and magnetic compass in the establishment of the new accessories. I used 13° East declination, the distances are to a 60d spike driven into the right side of the root crown of the bearing trees. A brass washer marked OPLS 83571 is attached to the BT blaze of the new bearing trees.