

USDA-FOREST SERVICE

Index File No. E-5

CORNER RECORD (SEARCH)

(Ref. FSM 7151.4)

Tract or Survey No. _____ Cor. No. _____


T 2S R. 35E

R.D. UKIAT County Lincoln

Merid. _____

N.F. Lincoln State OR

CORNER DIAGRAM

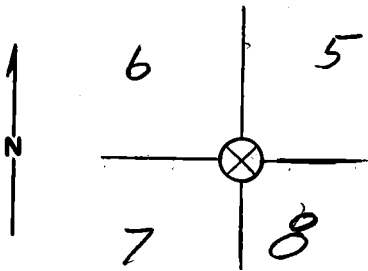

DESCRIBE CORNER MONUMENT FOUND

Mound of Rock
w/ Rock w/ 5 notches

DESCRIBE BEARING TREES OR OTHER OFFICIAL ACCESSORIES FOUND

The Remains of a Fir 2.6' Dist
Laying on the ground. exists
BT MARKS show 56

PHOTO IDENTIFICATION DATA

Photo No. _____
Filed At. _____
Object Ident. _____
Ident. By _____
Signature _____

DESCRIBE CORNER LOCATION RELATIVE TO NEAR-BY FEATURES, ALSO HOW TO REACH CORNER

Approx 40 W. of Rd (050) D

PLANE COORDINATE POSITION DATA

State _____ Zone _____
X _____
Y _____
Estab. By _____
Agency _____

Signature W Kelly

Title _____ Division _____ Headquarters 50

Date 8-23 7100-52 (3, 68)

CORNER RECORD (PERPETUATION)

MONUMENT : DESCRIBE NEW MONUMENT SET, OR WORK DONE TO PRESERVE EXISTING MONUMENT

ACCESSORIES : DESCRIBE NEW BT'S WITNESS OBJECTS ETC. ESTABLISHED, OR WORK DONE TO PRESERVE EXISTING EVIDENCE

Work Done By _____ Title _____ Date _____ State Registration No. or Agency _____ 10

Certified Cor. Record Prepared ? Yes No Filed At: _____ Date _____ 11

REMARKS

Index File No. T. R. M. Tract or Surv. No. Cor. 12 13