


CERTIFIED RECORD OF LAND CORNER MONUMENTATION

HISTORY OF ORIGINAL CORNER ESTABLISHED:

Corner not previously established.

T 2 S R 35 E G-11

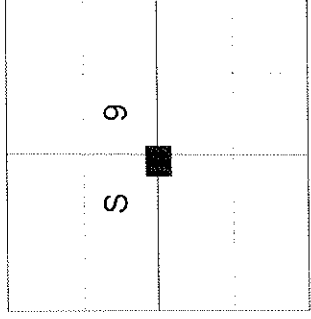

DESCRIPTION OF CORNER EVIDENCE FOUND:

None.

DESCRIPTION OF MONUMENT AND ACCESSORIES I ESTABLISHED TO PERPETUATE THE ORIGINAL LOCATION OF THIS CORNER:

At position determined by survey, I set a 2 ½"x30" aluminum pipe, 28" in the ground, with 2 ½" aluminum cap marked as shown below, in a collar of stone 1.5 ft. diam., from which:


NEW BEARING TREES:

- A 9" Lodgepole Pine bears North 73° East, a distance of 22.75 feet, marked C1/4 S9 BT.
- A 9" Lodgepole Pine bears South 39° East, a distance of 17.85 feet, marked C1/4 S9 BT.
- A 10" Lodgepole Pine bears South 28° West, a distance of 4.50 feet, marked C1/4 S9 BT.
- A 9" Lodgepole Pine bears North 10° West, a distance of 15.75 feet, marked C1/4 S9 BT.

Set a steel fencepost approx. 1 ft. West of corner.

I hereby certify that the corner was perpetuated on September 26, 2018.

Witness: Kyle Tucker

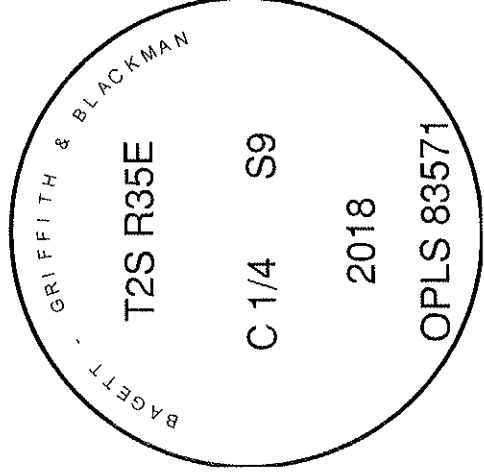

REGISTERED
PROFESSIONAL
LAND SURVEYOR

OREGON
June 2, 2010
JEFFREY S. HSU
83571

Renewal Date: June 30, 2019

I used a steel tape and magnetic compass in the establishment of the new accessories. I used 13° East declination, the distances are to a 60d spike driven into the side of the root crown of the bearing trees. A brass washer marked OPLS 83571 is attached to the BT blaze of the new bearing trees.

G-11

18-105-8