

CERTIFIED RECORD OF LAND CORNER MONUMENTATION

HISTORY OF ORIGINAL CORNER ESTABLISHED:

Corner originally established by James P. Currin and James E. Noland under GLO special contract dated May 4, 1887. Surveyor General field notes state:

A fir 5 ins. in diam. which I marked for ¼ M. cor. ¼ M on N & U.R. on W. faces. from which:

A Pine 4 ins. in diam bears N 18° W 7 lks dist. mkd. ¼ M.

UR BT

A Pine 6 ins. in diam bears S 85° E 13 lks dist. mkd. ¼ M.

UR BT

Corner found by Wayne O. Harris in 1975. Umatilla County survey M-46-C states:

Found Bearing tree for 56.5 mile post.

T 2 S R 35 E MM 56.5

UR			
	S		
	5		

DESCRIPTION OF CORNER EVIDENCE FOUND:

Found a downed 12" diam. Fir lying Northerly with 40" diam. Fir lying on top and lying Easterly. Upon opening the 12" Fir I found "¼ M" scribes on North face and fragmentary scribes on the West.

From which:

A 14" stump, 5' long, bears South 85° East a dist. of 8.50 ft., dead, down, and heavily rotted.

No sign of the North West bearing tree.

DESCRIPTION OF MONUMENT AND ACCESSORIES I ESTABLISHED TO MONUMENT THE ORIGINAL LOCATION OF THIS CORNER:

From the center of the stump hole of the found 12" fir tree, I set a 2 ¼" x 30" aluminum pipe 30" in the ground with 3" aluminum cap marked as shown below, from which:

NEW BEARING OBJECTS:

A 4" Douglas Fir bears North 81° East a dist. of 8.55 ft., marked UR MM 56 ¼ BT.

A 10" Ponderosa Pine bears South 46° East a dist. of 4.75 ft., marked UR MM 56 ¼ BT.

A 9" Ponderosa Pine bears South 43° West a dist. of 11.70 ft., marked UR MM 56 ¼ BT.


A 9" Ponderosa Pine bears North 79° West a dist. of 5.20 ft., marked UR MM 56 ¼ BT.

A fence line bearing North 20° East and South 20° West falls approx. 3 ¼' West of the monument.


Set steel fence post approx. 1' North.

I hereby certify that the corner was monumented on June 19, 2019.

Witness: Kyle A. Tucker

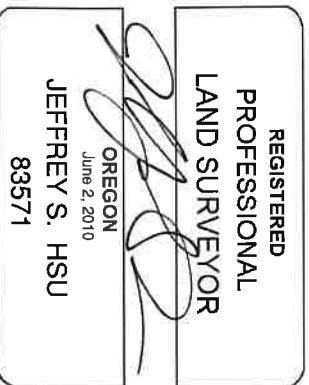

Renewal Date: June 30, 2021

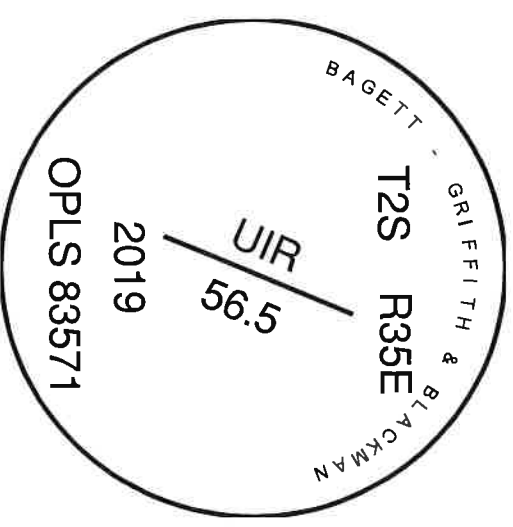

I used a steel tape and magnetic compass in the establishment of the new accessories. I used 13° East declination, the distances are to a 60d spike driven into the side of the root crown of the bearing trees. A brass washer marked OPLS 83571 is attached to the BT blaze of the new bearing trees.

UIR-MM-56.5

19-079-8