

USDA-FOREST SERVICE

Index

File No. _____

CORNER RECORD (SEARCH)

(Ref. FSM 7151.4)

Tract or

Survey No. UIR

Cor. No. 57 1/2

T 25 R. 35E


R.D. UKIAH

County Umatilla

Merid. _____

N.F. Umatilla State Ore

CORNER DIAGRAM

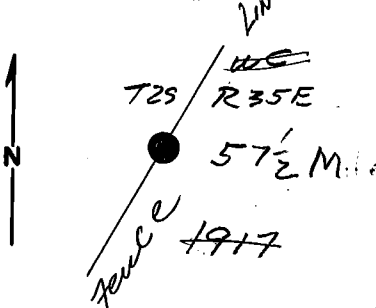

DESCRIBE CORNER MONUMENT FOUND

Brass Cap - Witness Cor.
1.98' S 17° 26' W of True Cor

WC
T25 / R35E
VIR / 57 1/2 M
1917

DESCRIBE BEARING TREES OR OTHER OFFICIAL ACCESSORIES FOUND

24" Pine S55W; 9.9'

Didnt open BT - SCAR exists
living tree

PHOTO IDENTIFICATION DATA

Photo No. _____

Filed At. _____

Object Ident. _____

Ident. By _____

Signature

PLANE COORDINATE POSITION DATA

State _____ Zone _____

X _____

Y _____

Estab. By _____

Agency

Signature

DESCRIBE CORNER LOCATION RELATIVE TO NEAR-BY FEATURES, ALSO HOW TO REACH CORNER

Approx 300' NE of VIR / 56 / 57

Title _____

Division _____

Headquarters _____

Date 9-85

7100-52 (3.68)

CORNER RECORD (PERPETUATION)

MONUMENT: DESCRIBE NEW MONUMENT SET, OR WORK DONE TO PRESERVE EXISTING MONUMENT

ACCESSORIES : DESCRIBE NEW BT'S WITNESS OBJECTS ETC. ESTABLISHED, OR WORK DONE TO PRESERVE EXISTING EVIDENCE

Work Done By _____ Title _____ Date _____ State Registration No. _____
or Agency _____

Certified Cor. Record Prepared ? Yes No Filed At _____ Date _____

REMARKS

Index File No. T. R. M. Tract or Surv. No. Cor.