

USDA-FOREST SERVICE

Index

File No. _____

T 25 R. 35E

Merid. 57

CORNER RECORD (SEARCH)

(Ref. FSM 7151.4)

Tract or

Survey No. UIR


Cor.

No. 58 1/2

R.D. UKIATH County Quartzite

N.F. Umatilla State Ore

CORNER DIAGRAM

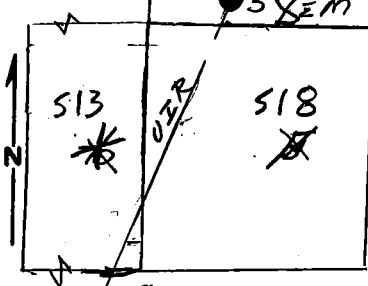

DESCRIBE CORNER MONUMENT FOUND

Brass Cap
58 1/2 M
UIR
1917

DESCRIBE BEARING TREES OR OTHER OFFICIAL ACCESSORIES FOUND

30" Pine N 77° 30' E

No BTs

PHOTO IDENTIFICATION DATA

Photo No. _____

Filed At. _____

Object Ident. _____

Ident. By _____

Signature

PLANE COORDINATE POSITION DATA

State _____ Zone _____

X _____

Y _____

Estab. By _____

Agency

Signature

Title

Division

Headquarters

Date

7100-52 (3-68)

8-83

4

5

CORNER RECORD (PERPETUATION)

MONUMENT: DESCRIBE NEW MONUMENT SET, OR WORK DONE TO PRESERVE EXISTING MONUMENT

ACCESSORIES: DESCRIBE NEW BT'S WITNESS OBJECTS ETC. ESTABLISHED, OR WORK DONE TO PRESERVE EXISTING EVIDENCE

24 7/3

Work Done By _____ Title _____ Date _____ State Registration No. or Agency _____

Certified Cor. Record Prepared? Yes No Filed At: _____ Date _____

REMARKS

*46
1-2
13
2
66
79
2
92*

*10 6 5
3 6 1
23*

Index File No. T. *0* R. M. Tract or Surv. No. Cor. *12*