


Index
File No. R-3

CORNER RECORD (SEARCH)
(Ref. FSM 7151.4)

Tract or Survey No. _____
Cor. S. 1/4 COR.
No. SEC. 19

T 2S R. 35 E R.D. LA GRANDE County UNION
Merid. WILLAMETTE N.F. WALLOWA-WHITMAN State OREGON

CORNER DIAGRAM

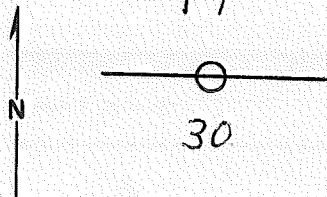

DESCRIBE CORNER MONUMENT FOUND

DESCRIBE BEARING TREES OR OTHER OFFICIAL ACCESSORIES FOUND

8" fir, brs. S. 13° E. 25 lks. scribing missing.
5" pine, brs. N. 40° W. 21 lks. scribing missing.

Metal location poster on 4" fir on the south side of the tree.

PHOTO IDENTIFICATION DATA

Photo No. _____
Filed At. _____
Object Ident. _____
Ident. By _____
Signature

DESCRIBE CORNER LOCATION RELATIVE TO NEAR-BY FEATURES, ALSO HOW TO REACH CORNER

Chained and compass line run in from south. Chain & compass run from main Spring Cr. to establish approximate 1/4 corner on original section line blazes. Located S. E. of Small grass opening
*Approximate 1/4 cor. No evidence of old 1/4 cor.

PLANE COORDINATE POSITION DATA

State _____ Zone _____
X _____
Y _____
Estab. By _____
Agency

Signature
GERALD L. GILDEMISTER

Title

Division

Headquarters

Date
10/7/55

7100-52-(3/68)

CORNER RECORD (PERPETUATION)

MONUMENT: DESCRIBE NEW MONUMENT SET, OR WORK DONE TO PRESERVE EXISTING MONUMENT

ACCESSORIES : DESCRIBE NEW BT'S WITNESS OBJECTS ETC. ESTABLISHED, OR WORK DONE TO PRESERVE EXISTING EVIDENCE

Work Done By _____ Title _____ Date _____ State Registration No. or Agency _____
Certified Cor. Record Prepared ? Yes No Filed At: _____ Date _____

REMARKS

Index File No. T. R. M. Tract or Surv. No. Cor.