

Form 874-9

U. S. DEPARTMENT OF AGRICULTURE
FOREST SERVICE

NATIONAL FOREST

CORNERS OF THE PUBLIC SURVEY

T. 29 R. 35E Wil Mer.

14 Corner common to Sections
between 27, and 38

DESCRIPTION OF CORNER

Corner consists of a Not found

Dimension above ground _____ inches.
Sketch grooves, letters, figures, or notches, on proper face or edge.

CARDINAL POSITION

DIAGONAL POSITION

N	W	S	E

NW	SW	SE	NE

Mound of _____ is located _____

Pits are located _____

Sketch markings of Bearing Trees (or Rocks) in proper box and fill blanks below, giving bearings from Corner to Trees and Distances in Links.

<u>14</u> <u>S</u>			
<u>BT</u>			

Species FLF _____

Diameter 8" _____

Bearing East _____

Distance ✓ _____

Do you believe this to be a genuine Land Office Corner? Yes

If not, why? _____

Geo. B. C. Lusk

Signature.

Forest Ranger

Title.

9-22-22


Date.

5-3027

T. 28 R. 35E Wil Mer.

8-3027

(Make sketch of topography near Corner.)

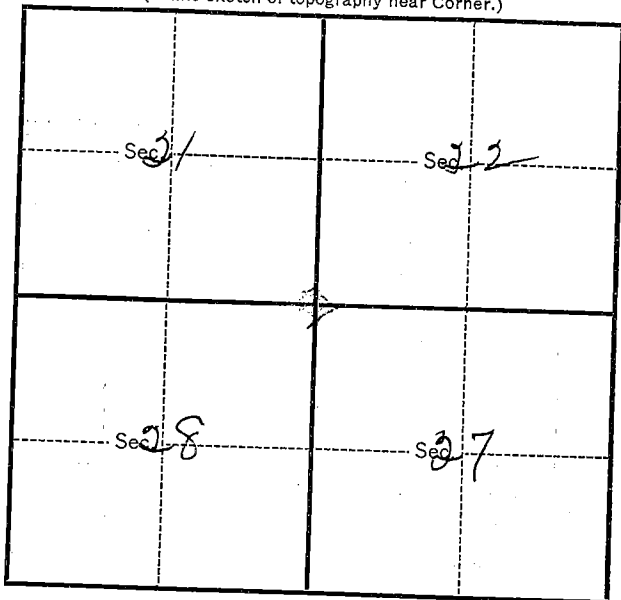

Metal Location Poster is on a _____
tree _____ inches diameter, on the _____
side of _____
from which this Corner bears _____
_____ chains distant.

Give any further facts which will aid in finding this
Corner again.

