

Index  
File No. Z-15

**CORNER RECORD (SEARCH)**  
(Ref. FSM 7151.4)

Tract or Survey No. Z 15 Cor. No. 1/4 **81**


T 1 S R. 36 E

R.D. Pendleton County Umatilla

Merid. Willamette

N.F. Umatilla State Oregon

CORNER DIAGRAM  
T1S R36E

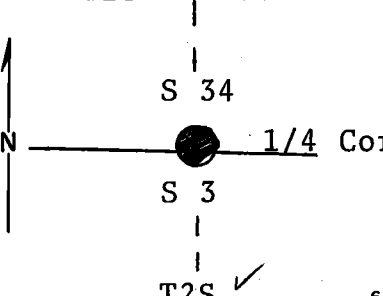

DESCRIBE CORNER MONUMENT FOUND

Brass cap set summer 1972. See reverse side.

PHOTO IDENTIFICATION DATA

Photo No. \_\_\_\_\_  
Filed At. \_\_\_\_\_  
Object Ident. \_\_\_\_\_  
Ident. By \_\_\_\_\_  
*Signature*

DESCRIBE BEARING TREES OR OTHER OFFICIAL ACCESSORIES FOUND

Found 30" pond. pine, live & good condition, with scribing visible, bearing S54°E 105 ft. dist. from the corner position.  
Found uprooted pine, bearing approx. N32°W 78 ft. from the corner position, no scribing visible.

PLANE COORDINATE POSITION DATA

State \_\_\_\_\_ Zone \_\_\_\_\_  
X \_\_\_\_\_  
Y \_\_\_\_\_  
Estab. By \_\_\_\_\_  
*Agency*

DESCRIBE CORNER LOCATION RELATIVE TO NEAR-BY FEATURES, ALSO HOW TO REACH CORNER

Established corner position N54°W 105 ft. from live 30" pine.



Signature \_\_\_\_\_ Title \_\_\_\_\_ Division \_\_\_\_\_ Headquarters \_\_\_\_\_ Date \_\_\_\_\_

CORNER RECORD (PERPETUATION)

MONUMENT: DESCRIBE NEW MONUMENT SET, OR WORK DONE TO PRESERVE EXISTING MONUMENT

Set 30x2½" iron pipe with 3" brass cap marked as shown, 25" in the ground  
& raised a mound of stone around the pipe.  
From which a new bearing tree:

9

ACCESSORIES : DESCRIBE NEW BT's WITNESS OBJECTS ETC. ESTABLISHED, OR WORK DONE TO PRESERVE EXISTING EVIDENCE

A fir 16" diam. bears N3°E, 107.5 ft. dist. marked T1S R36E<sup>1/4</sup>S34 BT.  
Distance taken to a brass washer in the blaze of the new bearing tree.  
Set a steel fence post approx. 5 ft. East from corner with Forest Boundary  
sign attached.  
Used steel tape & magnetic compass with declination equal 20° East.

10

Work Done By D. M. Ferguson Title Land Surveyor Date 7/12/69 State Registration No. 848  
or Agency

Certified Cor. Record Prepared ? Yes No Filed At Umatilla Co. Courthouse Date 11/16/72

11

REMARKS

12

Index File No. Z-15 T. R. M. Tract or Surv. No. Cor. 13