


CERTIFIED RECORD OF LAND CORNER MONUMENTATION

HISTORY OF ORIGINAL CORNER ESTABLISHED:

Corner originally established by John A. Hurlburt under GLO Contract No. 201, dated August 5, 1873. Surveyor General field notes state:
Set pine post 4 ft long, 3 in thick 2 ft in ground. for 1/4 sec cor
Fir 18 in dia S25°W 33 lks
Pine 8 in dia N12°W 82 lks

T 1 S R 36 E Z-07

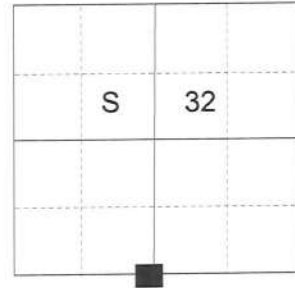

DESCRIPTION OF CORNER EVIDENCE FOUND:

A steel T post in a collar of stone. From which:
A 38" Douglas Fir bears South 25° West, a distance of 21.80 feet, alive and vigorous. Blaze marks have been chopped out and no discernable scribe marks visible. No remains of original post monument or the Northwest bearing tree.

DESCRIPTION OF MONUMENT AND ACCESSORIES I ESTABLISHED TO PERPETUATE THE ORIGINAL LOCATION OF THIS CORNER:

At record bearing and distance from the found Southwest bearing tree, I set a 2 1/2" x 30" aluminum pipe with a 2 1/2" aluminum cap marked as shown below, 28" in the ground, with a collar of stone 18" diameter. From which:

NEW BEARING OBJECTS:

A 6" Lodgepole Pine bears North 22° East, a distance of 55.60 feet, marked 1/4 S32 BT.
A 6" Lodgepole Pine bears South 4° West, a distance of 42.55 feet, marked 1/4 S5 BT.
A 10" Douglas Fir bears North 75° West, a distance of 34.80 feet, marked 1/4 S32 BT.


I set a steel fencepost approximately 1 foot North of corner monument.

I hereby certify that the corner was monumented on April 30, 2015.

Witness: Thomas J. Kopp



Renewal Date: June 30, 2017

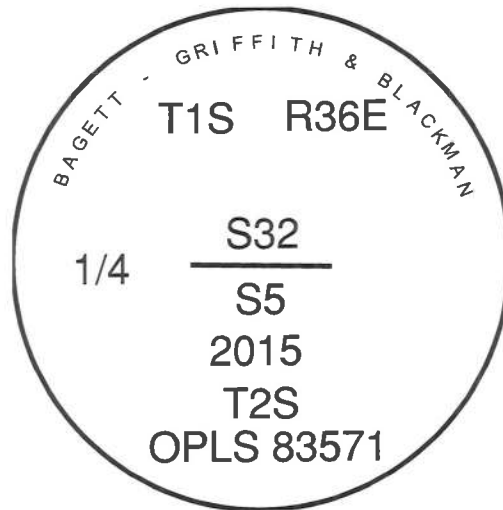

I used a steel tape and magnetic compass in the establishment of the new accessories. I used 16° East declination, the distances are to a 60d spike driven into the right side of the root crown of the bearing trees. A brass washer marked OPLS 83571 is attached to the BT blaze of the new bearing trees.

Z-07

15-036-B