

OREGON CORNER RESTORATION FORM

Section 3 Township 3N Range 27E
 County Umatilla Date 06-29-02
 Corner Designation: 3N27E-7

Condition Report Only
 Not Found
 Remonumented
 Unrecorded
 Surveyed In
 Referenced Out


Previous Renewals / Surveys, etc.

Survey 90-49-B records finding a brass cap at this corner.


Monument and Accessories Found: (condition and source)

Found a bent 1 3/4 inch pipe 6" below the road surface with rivet. Shot the location at approximate center of lower portion of pipe.

DIAGRAM

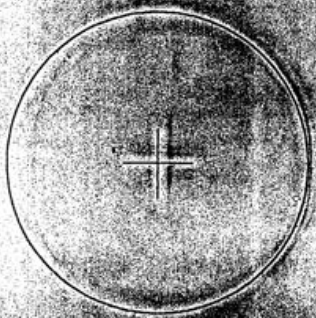

SKETCH

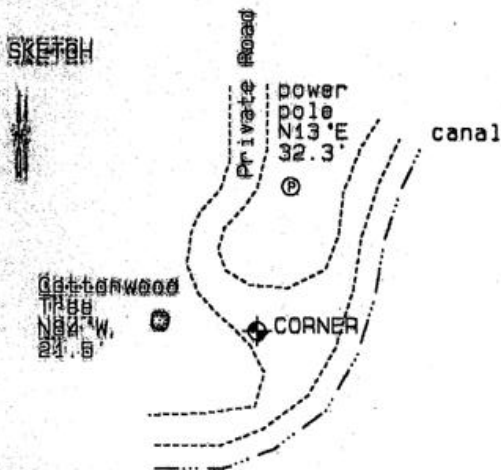

MONUMENT (S) AND ACCESSORIES SET (Procedures and Description)

None.

REFERENCES SET

None

Made GPS tie to TPI Station
 Stanfield East Base
 Latitude: 45 45 46.56293 N
 Longitude: 119 24 50.25236 W
 NAD 83 (1991)

Oregon State Plane Coord. - North Zone
 Northing: 766121.05
 Easting: 8479265.01
 Ortho Height: 609.61
 Ellipsoidal Height: 539.71

Location and Comments

Magnetic Declination
20°E

Surveyors Seal

From the junction of Westland Road and I84, go south on Coll Jordan Road 1.0 mile, then continue on Coll Jordan Road southwest 2.1 miles. Then go south on a private road 0.8 mile to the corner.

REGISTERED
 PROFESSIONAL
 LAND SURVEYOR

David L. Haddock

RECEIVED BY:

Firm / Agency

Date: 12-02
 Rec'd By: [Signature]
 No: 02-282-9

Haddock Surveying
 P. O. Box 1874
 Pendleton, OR 97801
 (541) 278-2174

OREGON
 JULY 12, 1968
 DAVID L. HADDOCK
 852