

# OREGON CORNER RESTORATION FORM

Section 12 Township 3N Range 27E  
 County Umatilla Date 06-14-02  
 Corner Designation: 3N27E25


Condition Report Only  
 Not Found  
 Remonumented  
 Unrecorded  
 Surveyed In  
 Referenced Out

**Previous Renewals / Surveys, etc.**

Gould reports setting a 6-0 brass capped monument here in 1940.  
 Survey 90-49-B reports setting a brass capped monument as a witness to that monument.

**Monument and Accessories Found: (condition and source)**

Found the brass capped witness monument. Computed corner coordinates based on tie to witness monument and other adjacent corners.

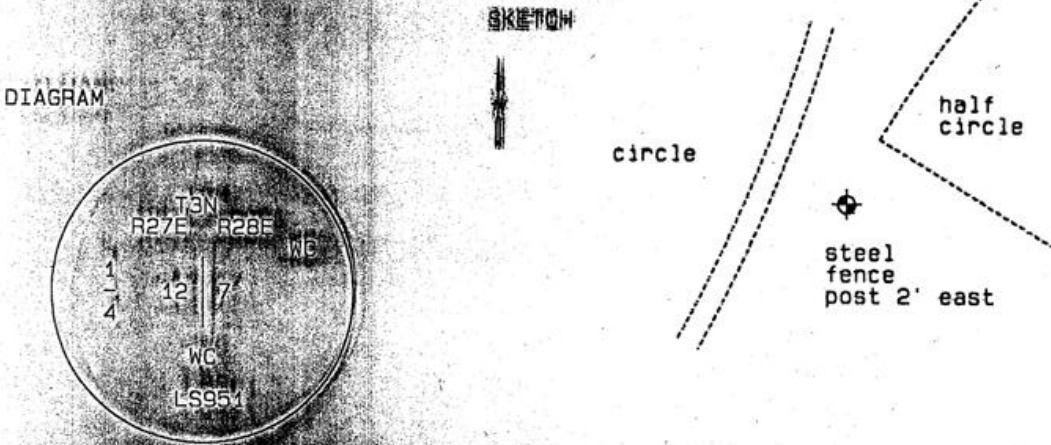

**MONUMENT (S) AND ACCESSORIES SET (Procedures and Description)**

None.

**REFERENCES SET**

None.

Made GPS tie to T3N Station Stanfield East Base  
 Latitude 45 45 20.4655 N  
 Longitude 119 22 20.8662 W  
 NAD 83 (1991)

Oregon State Plane Coord. - North Zone  
 Northing 763624.73  
 Easting 8489882.87  
 Ortho Height  
 Ellipsoidal Height

**Location and Comments**

Compass Declination 20°E

Surveyors Seal

From the junction of 854 and Westland Road, go south on Jordan Road 1.2 miles, then take Madison Farm Road south 1.4 miles to corner.

REGISTERED PROFESSIONAL LAND SURVEYOR

**RECEIVED BY:**

Firm / Agency

David L. Haddock

Date: 12-02  
 Rec'd By: KIC  
 No: 02-282-9

Haddock Surveying  
 P. O. Box 1674  
 Pendleton, OR 97801  
 (503) 278-2174

OREGON  
 JULY 12, 1968  
 DAVID L. HADDOCK  
 852

RENEWS 6-30-03