

OREGON CORNER RESTORATION FORM

T2N R27E A1

Section 6, Township 2N, Range 27E,
 County Morrow, Date November 15, 2004.

- Condition Report
- Not Found
- Remonumented
- Unrecorded
- Surveyed in
- Referenced out


Township corner common to Townships 2 and 3 North
 Ranges 26 and 27 East, W.M., Umatilla County, Oregon.

Previous Renewals / Surveys, etc.

The corner was originally set by Ebenezer E. Haft under Contract No. 91 dated September 11, 1860. His record Reads: Set post for corner to Townships 2 & 3 North, Ranges 26 & 27 East in mound with trench & pits and deposit a pint of charcoal as per instructions. The corner was remonumented by Otis Gould under Contract No. 217 dated March 12, 1938. His Record reads: ... the rotten remains of old stake, bearing traces of incomplete scribe marks. At point for cor. Set an iron post, 3 ft. long, 3 ins. diam., 27 ins. in the ground, with the marked stake deposited at the base, for cor. to Tps. 2 and 3 N., Rs. 26 and 27 E., with brass cap.... dig pits 18 x 18 x 12 ins. in each sec., 3 ft. dist..

Monument and accessories found: (Condition and source)

I found a 3 1/2" brass cap on a 3" iron pipe in good condition. The cap protrudes approximately 8" above the surface of the ground. A broken off steel guard post lay on the ground nearby.

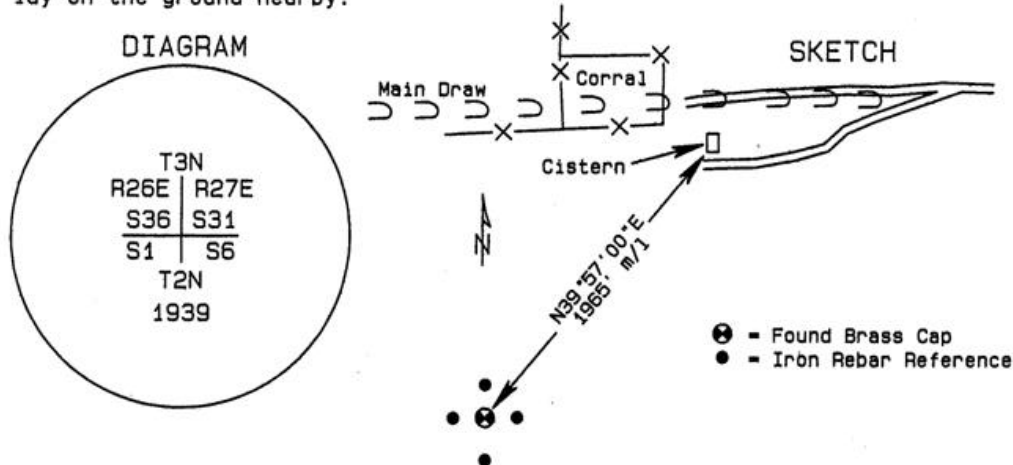

Monument and accessories set: (Procedures and description)

For references I set four 5/8" x 24" iron rebars with 1.25" orange plastic caps stamped WTS and 56295LS approximately 12" below the surface of the ground:
 an iron rebar bears N0°22'51"E 51.86 feet;
 an iron rebar bears N89°32'45"E 51.29 feet;
 an iron rebar bears S0°14'45"E 66.73 feet;
 an iron rebar bears S89°12'00"W 50.78 feet;
 The monument and references were tied with a Trimble R7/R8 system using static surveying procedures. Bearings are Grid.

Location and Comments
 SPC Oregon North, NAD 83-91
 Northing = 739,268.66 ft
 Easting = 8,458,131.77 ft

Compass Declination

Surveyor's Seal

Witnessed By:
 RECEIVED BY:
Umatilla County Surveyor
 Date: 5-05
 Rec'd By: KK
 No. 05-111-C

Firm / Agency
 Witness Tree Surveying
 P.O. Box 6
 Pilot Rock, OR 97868
 Party Chief
 Stephen K. Haddock, PLS

**REGISTERED
 PROFESSIONAL
 LAND SURVEYOR**

Stephen K. Haddock

**OREGON
 JULY 9, 2001
 STEPHEN K. HADDOCK
 56295LS**

RENEWAL DATE 6-30-05