

OREGON CORNER RESTORATION FORM

Section 11 Township 3N Range 27E
 County Umatilla Date 06-27-02

Corner Designation: 3N27E25

Condition Report Only
 Not Found
 Remonumented
 Unrecorded
 Surveyed In
 Referenced Out

Previous Renewals / Surveys, etc.

The GLO set a brass capped witness corner here in 1940.
 Survey S-90-B set a brass capped witness corner here.


Monument and Accessories Found (Condition and source)

Found both the GLO and Survey 90-49-B brass capped witness corners in good condition. Computed corner location from the witness corner and from adjacent brass capped corners.

Found both the witness corner and the filed survey plat to have transposed numbers based on the record location of other brass capped monuments tied. The distance recorded as 426.00' should have been 452.00'.

SKETCH

DIAGRAM

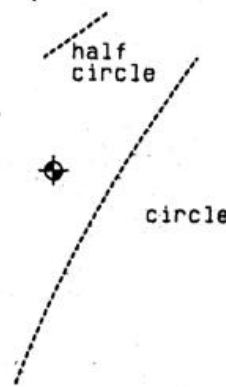

MONUMENT (S) AND ACCESSORIES SET (Procedures and Description)

None.

REFERENCES SET

None.

Made GPS tie to T3N Station
 Stanfield East Base
 Latitude: 45 44 46.67 98 N
 Longitude: 119 22 2 21678 W
 NAD 83 (1991)

Oregon State Plane Coord. - North Zone
 Northing: 766276.61
 Easting: 8489829.44
 Ortho Height
 Ellipsoidal Height

Location and Comments: Compass Declination 20°E Surveyors Seal

From the Jct. of T3N with Westland Road, go south on gravel road 1/4 mile to the Madison Farm Road. Follow the Madison Farm Road south 0.5 mile. The witness corner is along side the road.

REGISTERED
 PROFESSIONAL
 LAND SURVEYOR

David L. Haddock

RECEIVED BY:

Firm / Agency

Date: 12-02
 Rec'd By: K.R.
 No: 02-28259

Haddock Surveying
 P. O. Box 1574
 Pendleton, OR 97801
 (541) 278-2174

OREGON
 JULY 12, 1968
 DAVID L. HADDOCK
 852

RENEWS 6-30-03