

**OREGON CORNER RESTORATION FORM**

Section 6,7  
County Umatilla

Township 3N  
Date: 09/22/09

Range 29E

Corner Designation: 3N29E1

Corner common to sections 6 and 7, T3NR29E, 1 and 12, T3NR28E.

_____	Condition Report Only
<input checked="" type="checkbox"/>	Not Found
<input checked="" type="checkbox"/>	Re-monumented
_____	Unrecorded
<input checked="" type="checkbox"/>	Surveyed In
<input checked="" type="checkbox"/>	Referenced Out


**Previous Renewals / Surveys, etc.**

Originally Surveyed by N.H. Gates in 1859. He set a post in a mound of earth.


**Monuments and Accessories Found: (Condition and Source)**

None.

Diagram

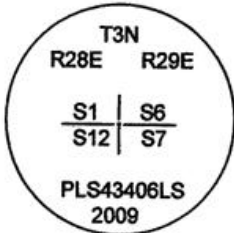

Sketch

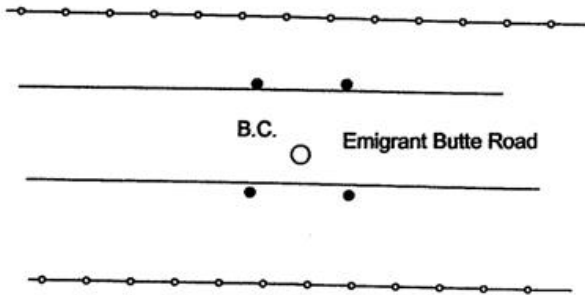

NAD 83/91  
OREGON STATE PLANE NORTH  
INTERNATIONAL FEET

N766472.70  
E8521481.63

LAT - 45° 45' 44.00226" N  
LON - 119° 14' 54.74165" W

**Monument (s) Set (Procedures and Description)**

A 1 1/2" X 14" galvanized Iron pipe with 2 1/2" Brass Cap, by single proportionate methods.

**References Set:**

- A 3/8" x 30" Iron rebar w/rpc #43406 lies N 49°45' E, 29.04'.
- A 3/8" x 30" Iron rebar w/rpc #43406 lies N 35°15' W, 25.65'.
- A 3/8" x 30" Iron rebar w/rpc #43406 lies S 51°45' W, 19.17'.
- A 3/8" x 30" Iron rebar w/rpc #43406 lies S 52°00' E, 19.75'.

**Location and Comments**

The corner is .5 miles West from the intersection of Echo Meadows Road and Emigrant Butte Road.

**Compass Declination**

17° E

**Surveyors Seal**

REGISTERED  
PROFESSIONAL  
LAND SURVEYOR

*Robert D. English*  
OREGON  
JANUARY 11, 2005  
ROBERT DOUGLAS ENGLISH  
43406LS

RENEWAL DATE: 12/31/09

**RECEIVED BY:**

Date: 9-09  
Rec'd By: KE  
No. 09-146-A

**Firm / Agency**

Survey One, LLC.  
P.O. Box 382  
Pendleton, OR 97801  
(541) 276-2055