

# CORNER RESTORATION FORM

Township 3N Range 28E Section 7 County UMATILLA

State OREGON Date 12/21/12 Number H1

Corner Designation : SOUTH 1/16 S12 | S7


- Condition Report Only
- Not Found
- Renewed
- Surveyed In
- Referenced

Previous Renewals \_\_\_\_\_

Monument (s) Found: (Condition and Source)  
 FOUND 2 1/2 INCH BRASS CAP ON BADLY BENT  
 2 INCH O.D. PIPE. THE PIPE WAS STRAIGHTENED  
 AND RESET AT THE FOUND LOCATION. MONUMENT  
 IS NOTED IN RECORD OF SURVEY FILED AS 90-49-B  
 UMATILLA COUNTY SURVEY RECORDS.

MONUMENT DETAIL

Found  Set

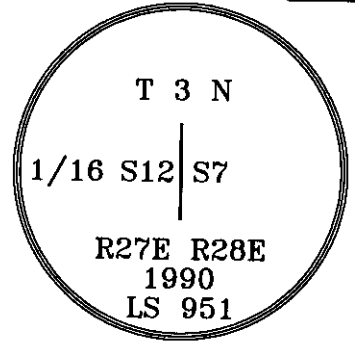


Accessories Found: \_\_\_\_\_

NONE

Monument & Accessories Set (Procedure and Description)

Sketch of Monument, Accessories and General Area

SEARCH AREA IS BETWEEN  
 WEST EDGE OF ROAD AND A  
 FENCE CORNER WITH FENCES  
 RUNNING SOUTH AND WEST

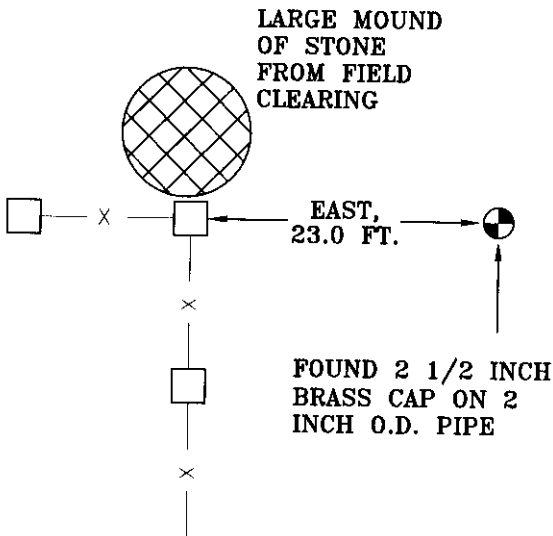

**REGISTERED PROFESSIONAL LAND SURVEYOR**

*Danny K. Cummings*  
 OREGON  
 JAN. 21, 1988  
**DANNY K. CUMMINGS**  
 2316

RENEWAL DATE : 12-31-13

Agency CK3, LLC.  
 945 S.W. ORCHARD AVE., HERMISTON OR

Party Chief Rod Lewis

Notekeeper Rod Lewis

Witness(s) \_\_\_\_\_

Field Book 0-287

Client Cascade Natural Gas

Job # VO-12051

**COUNTY SURVEYOR RECORDING INFO**

Received *S. 2/1/2013*

Filed *S. Res*

Survey No. 13-015-6

Drawing No. \_\_\_\_\_

Index No. H-1