

CORNER RESTORATION FORM

Township 3N Range 28E Section 7 County UMATILLA

State OREGON Date 12/21/12 Number J1

Corner Designation : SOUTHWEST CORNER

- Condition Report Only
- Not Found
- Renewed
- Surveyed In
- Referenced


Previous Renewals _____

Monument (s) Found: (Condition and Source)

FOUND BADLY BENT 2 IN. IRON PIPE WITH NO
CAP. PIPE WAS STRAIGHTENED AND RESET IN
FOUND POSITION. MONUMENT IS NOTED IN
RECORD OF SURVEY FILED AS 00-33-B UMATILLA
COUNTY SURVEY RECORDS.

MONUMENT DETAIL

Found Set

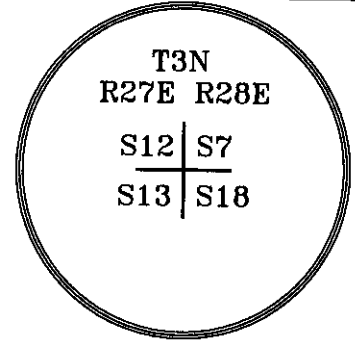

DETAIL IS FOR
REFERENCE ONLY
CAP WAS MISSING


Accessories Found: _____

NONE

Monument & Accessories Set (Procedure and Description)

Sketch of Monument, Accessories and General Area

SEARCH AREA IS AT E. EDGE OF
ROAD, W. OF PIVOT IRR. FIELD
AND 166.5 FT. SSE OF S. POST
OF 3 POST FENCE BRACE

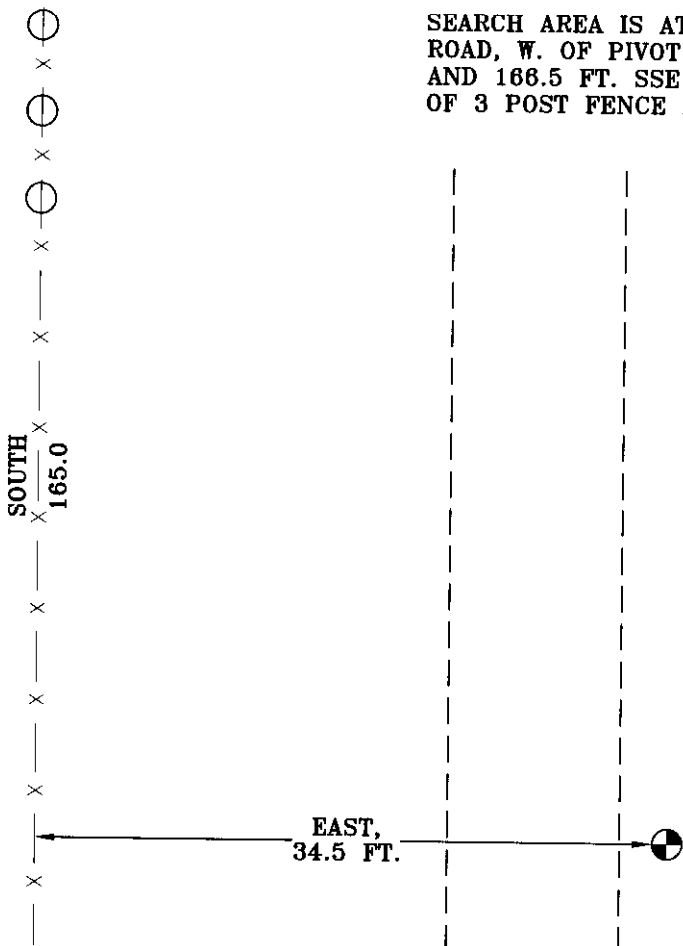

**REGISTERED
PROFESSIONAL
LAND SURVEYOR**

Danny K. Cummings

OREGON
JAN. 21, 1988
DANNY K. CUMMINGS
2316

RENEWAL DATE : 12-31-13

Agency CK3, LLC.
945 S.W. ORCHARD AVE., HERMISTON OR

Party Chief Rod Lewis
Notekeeper Rod Lewis

Witness(s) _____

Field Book 0-287

Client Cascade Natural Gas

Job # V0-12051

**COUNTY SURVEYOR
RECORDING INFO**

Received 2/1/2013

Filed J. Oles

Survey No. 13-015-C

Drawing No. _____

Index No. J-1